


1 LOCATION OF WATER WELL: Butler	FRACTION SE 1/4 SE 1/4 NE 1/4	Section Number 22	Township Number T 24 S	Range Number R 3E E/W
--	---	-----------------------------	----------------------------------	---------------------------------

Distance and direction from nearest town or city street address of well if located within city?
Approx. 4 m. E. of Whitewater Road, 1/4 N. Whitewater, Kansas

2 WATER WELL OWNER: LOGAN, Jerry	RR#, ST. ADDRESS, BOX #: Rt. #1 Box 172C	Board of Agriculture, Division of Water Resource
CITY, STATE, ZIP CODE: Whitewater, Kansas	67154	Application Number:

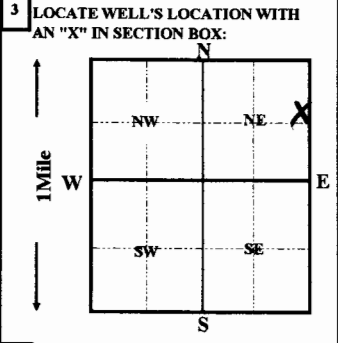

4 DEPTH OF COMPLETED WELL 80 ft.	ELEVATION:
Depth(s) groundwater Encountered 1 ft. 2 ft. 3 ft.	
WELL'S STATIC WATER LEVEL 20 FT. BELOW LAND SURFACE MEASURED ON 06/01/1993	
Pump test data:	Well water was ft. after hours pumping gpm
Est. Yield gpm:	Well water was ft. after hours pumping gpm
Bore Hole Diameter 12 in. to 80 ft., and in. to ft.	
WELL WATER TO BE USED AS:	5 Public water supply 8 Air conditioning 11 Injection well
1 Domestic 3 Feedlot 6 Oil field water supply 9 Dewatering 12 Other (Specify below)	
2 Irrigation 4 Industrial 7 Lawn and garden only 10 Monitoring well	
Was a chemical/bacteriological sample submitted to Department? Yes	No <input checked="" type="checkbox"/> ; If yes, mo/day/yr sample was submitted
Water Well Disinfected? Yes <input checked="" type="checkbox"/> No	

5 TYPE OF CASING USED:	5 Wrought iron	8 Concrete tile	CASING JOINTS:	Glued <input checked="" type="checkbox"/> Clamped
1 Steel 3 RMP (SR)	6 Asbestos-Cement	9 Other (Specify below)	Welded	
2 PVC 4 ABS	7 Fiberglass	SDR-26	Threaded	
Blank casing Diameter 5 in. to 40 ft., Dia in. to ft.	weight 2.35 lbs./ft.	Wall thickness or gauge No. .214		
Casing height above land surface 12 in.,				
TYPE OF SCREEN OR PERFORATION MATERIAL:	5 Fiberglass	8 RMP (SR)	11 other (specify)	
1 Steel 3 Stainless Steel	6 Concrete tile	9 ABS	12 None used (open hole)	
2 Brass 4 Galvanized steel				
SCREEN OR PERFORATION OPENING ARE:	5 Gauzed wrapped	8 Saw cut	11 None (open hole)	
1 Continous slot 3 Mill slot	6 Wire wrapped	9 Drilled holes		
2 Louvered shutter 4 Key punched	7 Torch cut	10 Other (specify)		
SCREEN-PERFORATION INTERVALS:	from 40 ft. to 80 ft., From ft. to ft.			
GRAVEL PACK INTERVALS:	from 24 ft. to 80 ft., From ft. to ft.			

6 GROUT MATERIAL:	1 Neat cement	2 Cement grout	3 Bentonite	4 Other
Grout Intervals: From 4 ft. to 24 ft., From ft. to ft.				
What is the nearest source of possible contamination:	10 Livestock pens	14 Abandon water well		
1 Septic tank 4 Lateral lines 7 Pit privy	11 Fuel storage	15 Oil well/Gas well		
2 Sewer lines 5 Cess pool 8 Sewage lagoon	12 Fertilizer storage	16 Other (specify below)		
3 Watertight sewer lines 6 Seepage pit 9 Feedyard	13 Insecticide storage	None Apparent		
Direction from well?	How many feet?			

FROM	TO	LITHOLOGIC LOG	FROM	TO	PLUGGING INTERVALS
0	3	topsoil			SEPTIC SYSTEM NOT INSTALLED AT THIS TIME
3	30	clay			
30	35	fine sand and shale bits			
35	80	grey shale			

7 CONTRACTOR'S OR LANDOWNER'S CERTIFICATION: This water well was (1) constructed, (2) reconstructed, or (3) plugged under my jurisdiction and was completed on (mo/day/year) 06/01/1993 and this record is true to the best of my knowledge and belief. Kansas Water Well Contractor's License No. 236 This Water Well Record was completed on (mo/day/yr) 09/21/93
Under the business name of Harp Well & Pump Service, Inc. by (signature) <i>Jane Frederick</i>
650