USE TYPEWRITER OR BALL POINT PEN-PRESS FIRMLY, PRINT CLEARLY.

WATER WELL RECORD
KSA 82a-1201-1215

Kansas Department of Health and Environment-Division of Environment
(Water well Contractors)
Topeka, Kansas 66620

1. Location of well:	County	Fraction	Section number	Township number	Range number
	BUTLER	SW 1/4 SE 1/4 NW 1/4	32	T 24 S	R 3-E E/W

2. Distance and direction from nearest town or city: FROM EAST SIDE OF WHITEWATER 3 M SOUTH 1/4 EAST
Street address of well location if in city:

3. Owner of well: Wayne Entz
R.R. or street: 3131 Arkansas
City, state, zip code: Wichita, KANSAS

4. Locate with "X" in section below:

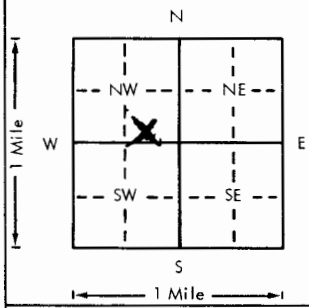

Sketch map:

6. Bore hole dia. 8 in. Completion date 4-12-79
Well depth 51 ft.

7. __ Cable tool X Rotary __ Driven __ Dug
__ Hollow rod __ Jetted __ Bored __ Reverse rotary

8. Use: X Domestic __ Public supply __ Industry
__ Irrigation __ Air conditioning __ Stock
__ Lawn __ Oil field water __ Other

9. Casing: Material Plastic Height: Above or below
Threaded ___ Welded Glue Surface 48 in.
RMP ___ PVC X Weight 2.82 lbs./ft.
Dia. 5 in. to 30 ft. depth Wall Thickness: inches or
Dia. ___ in. to ___ ft. depth gage No. 2.58

5. Type and color of material

	From	To
CLAY	0	10
CLAY	10	20
COURSE SAND	20	30
COURSE GRAVEL	30	45
CLAY	45	50
SHALE	50	51

(Use a second sheet if needed)

10. Screen: Manufacturer's name ~~Schlumber~~ Plastic Pipe
Type ~~[illegible]~~ Dia. 3"
Slot/gauze Slot 1/16 Length 20
Set between 31 ft. and 51 ft.
___ ft. and ___ ft.
Gravel pack? Yes Size range of material 1/8-1/4

11. Static water level: mo./day/yr.
10 ft. below land surface Date 4-13-79

12. Pumping level below land surfaces:
___ ft. after ___ hrs. pumping ___ g.p.m.
___ ft. after ___ hrs. pumping ___ g.p.m.
Estimated maximum yield 20 g.p.m.

13. Water sample submitted: mo./day/yr.
__ Yes X No Date ___

14. Well head completion:
__ Pitless adapter 48 Inches above grade

15. Well grouted? Yes
With: ___ Neat cement ___ Bentonite X Concrete
Depth: From 3 ft. to 14 ft.

16. Nearest source of possible contamination:
ft. 1 mile Direction NW Type CREEK
Well disinfected upon completion? X Yes ___ No

17. Pump: __ Not installed
Manufacturer's name Goulds
Model number VET0740 HP 3/4 Volts 230
Length of drop pipe 40 ft. capacity 10 g.p.m.
Type:
X Submersible __ Turbine
__ Jet __ Reciprocating
__ Centrifugal __ Other

18. Elevation:

Topography:
__ Hill
__ Slope
X Upland
__ Valley

19. Remarks:
10' JET STRAM 200 PSI
A.U.C. CASING

20. Water well contractor's certification:
This well was drilled under my jurisdiction and this report is true to the best of my knowledge and belief.
Martin Supply 3162
Business name License No.
Address 500 West 22nd N. Wichita KS
Signed Bruce Schmidt Date 4-13-79
Authorized representative

Forward the white, blue and pink copies to the Department of Health and Environment

Form WWC-5

MI-1023

24 T 3 R E/W 32 Sec 1/4 1/4 1/4 KS SWSE NW