


1 LOCATION OF WATER WELL: County: Butler Fraction: SE 1/4 NW 1/4 SE 1/4 Section Number: 34 Township Number: T 24 S Range Number: R 3 E

Distance and direction from nearest town or city street address of well if located within city?
4 West 2-5 of Patwin Kan

2 WATER WELL OWNER: Dwight Bernitze
 RR#, St. Address, Box #: R1 Box 118 Wittwater Kan
 City, State, ZIP Code: _____ Board of Agriculture, Division of Water Resources
 Application Number: _____

3 LOCATE WELL'S LOCATION WITH AN "X" IN SECTION BOX:

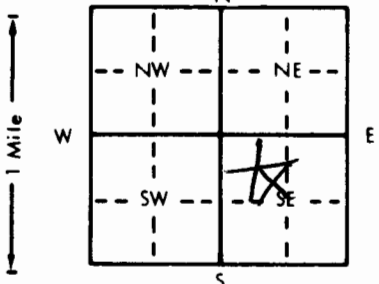

4 DEPTH OF COMPLETED WELL: 30 ft. ELEVATION: _____

Depth(s) Groundwater Encountered 1. 25 ft. 2. _____ ft. 3. _____ ft.

WELL'S STATIC WATER LEVEL 10 ft. below land surface measured on mo/day/yr

Pump test data: Well water was _____ ft. after _____ hours pumping _____ gpm

Est. Yield 25 gpm: Well water was _____ ft. after _____ hours pumping _____ gpm

Bore Hole Diameter: 1 1/2 in. to _____ ft., and _____ in. to _____ ft.

WELL WATER TO BE USED AS: 5 Public water supply 8 Air conditioning 11 Injection well

1 Domestic 3 Feedlot 6 Oil field water supply 9 Dewatering 12 Other (Specify below)

2 Irrigation 4 Industrial 7 Lawn and garden only 10 Monitoring well

Was a chemical/bacteriological sample submitted to Department? Yes _____ No X; If yes, mo/day/yr sample was submitted _____

Water Well Disinfected? Yes X No _____

5 TYPE OF BLANK CASING USED:

1 Steel 3 RMP (SR) 5 Wrought iron 8 Concrete tile CASING JOINTS: Glued X Clamped _____

2 PVC 4 ABS 6 Asbestos-Cement 9 Other (specify below) Welded _____

Blank casing diameter: 8 in. to 20 ft., Dia _____ in. to _____ ft., Dia _____ in. to _____ ft.

Casing height above land surface: 18 in., weight 160 lbs./ft. Wall thickness or gauge No. 12 1/4

TYPE OF SCREEN OR PERFORATION MATERIAL:

1 Steel 3 Stainless steel 5 Fiberglass 8 RMP (SR) 10 Asbestos-cement

2 Brass 4 Galvanized steel 6 Concrete tile 9 ABS 11 Other (specify) _____

SCREEN OR PERFORATION OPENINGS ARE:

1 Continuous slot 3 Mill slot 5 Gauzed wrapped 8 Saw cut 11 None (open hole)

2 Louvered shutter 4 Key punched 6 Wire wrapped 9 Drilled holes

SCREEN-PERFORATED INTERVALS: From 20 ft. to 30 ft., From _____ ft. to _____ ft.

GRAVEL PACK INTERVALS: From _____ ft. to _____ ft., From _____ ft. to _____ ft.

6 GROUT MATERIAL: 1 Neat cement 2 Cement grout 3 Bentonite 4 Other _____

Grout Intervals: From 3 ft. to 23 ft., From _____ ft. to _____ ft., From _____ ft. to _____ ft.

What is the nearest source of possible contamination:

1 Septic tank 4 Lateral lines 7 Pit privy X Livestock pens 14 Abandoned water well

2 Sewer lines 5 Cess pool 8 Sewage lagoon 11 Fuel storage 15 Oil well/Gas well

3 Watertight sewer lines 6 Seepage pit 9 Feedyard 12 Fertilizer storage 16 Other (specify below) _____

Direction from well? E 13 Insecticide storage _____

How many feet? 400

FROM	TO	LITHOLOGIC LOG	FROM	TO	PLUGGING INTERVALS
0	4	Soil			
4	15	Clay			
15	30	Gravel			

7 CONTRACTOR'S OR LANDOWNER'S CERTIFICATION: This water well was X constructed, (2) reconstructed, or (3) plugged under my jurisdiction and was completed on (mo/day/year) 2/16/94 and this record is true to the best of my knowledge and belief. Kansas

Water Well Contractor's License No. 251 This Water Well Record was completed on (mo/day/yr) 2/23/94

under the business name of Winter Well Drill by (signature) Charles Winter