

Corrected


WATER WELL RECORD Form WWC-5

Division of Water Resources App. No. [ ] Well ID [ ]

Original Record  Correction  Change in Well Use

1 LOCATION OF WATER WELL: County: Butler Fraction NW NE SE SW NE SE SW NW 1/4 1/4 Section Number 28 Township Number T 24 S Range Number R 3 E W

2 WELL OWNER: Last Name: HARDER First: DAVE Street or Rural Address where well is located (if unknown, distance and direction from nearest town or intersection): If at owner's address, check here: [x] City: WHITEWATER State: KS ZIP: 67154

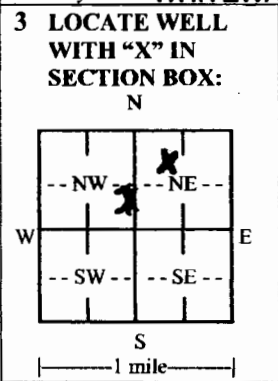

4 DEPTH OF COMPLETED WELL: 100 ft. Depth(s) Groundwater Encountered: 1) 23 ft. 2) ft. 3) ft. or 4) Dry Well WELL'S STATIC WATER LEVEL: 23 ft. [x] below land surface, measured on (mo-day-yr) 02/01/2022 [ ] above land surface, measured on (mo-day-yr) Pump test data: Well water was ft. after hours pumping gpm Well water was ft. after hours pumping gpm Estimated Yield: 20 gpm Bore Hole Diameter: 12 in. to 100 ft. and in. to ft.

5 Latitude: 37.966990 (decimal degrees) Longitude: -97.125296 (decimal degrees) Datum: [x] WGS 84 [ ] NAD 83 [ ] NAD 27 Source for Latitude/Longitude: [ ] GPS (unit make/model: ) (WAAS enabled? [ ] Yes [ ] No) [ ] Land Survey [ ] Topographic Map [ ] Online Mapper:

6 Elevation: ft. [ ] Ground Level [ ] TOC Source: [ ] Land Survey [ ] GPS [ ] Topographic Map [ ] Other

7 WELL WATER TO BE USED AS: 1. Domestic: [ ] Household [ ] Lawn & Garden [x] Livestock 2. Irrigation [ ] 3. Feedlot [ ] 4. Industrial [ ] 5. Public Water Supply: well ID 6. Dewatering: how many wells? 7. Aquifer Recharge: well ID 8. Monitoring: well ID 9. Environmental Remediation: well ID [ ] Air Sparge [ ] Soil Vapor Extraction [ ] Recovery [ ] Injection 10. Oil Field Water Supply: lease 11. Test Hole: well ID [ ] Cased [ ] Uncased [ ] Geotechnical 12. Geothermal: how many bores? a) Closed Loop [ ] Horizontal [ ] Vertical b) Open Loop [ ] Surface Discharge [ ] Inj. of Water 13. Other (specify):

Was a chemical/bacteriological sample submitted to KDHE? [ ] Yes [x] No If yes, date sample was submitted: Water well disinfected? [x] Yes [ ] No

8 TYPE OF CASING USED: [ ] Steel [x] PVC [ ] Other CASING JOINTS: [x] Glued [ ] Clamped [ ] Welded [ ] Threaded Casing diameter 5 in. to 100 ft., Diameter in. to ft., Diameter in. to ft. Casing height above land surface 16 in. Weight lbs./ft. Wall thickness or gauge No. 26

TYPE OF SCREEN OR PERFORATION MATERIAL: [ ] Steel [ ] Stainless Steel [x] PVC [ ] Other (Specify) [ ] Brass [ ] Galvanized Steel [ ] None used (open hole)

SCREEN OR PERFORATION OPENINGS ARE: [ ] Continuous Slot [x] Mill Slot [ ] Gauze Wrapped [ ] Torch Cut [ ] Drilled Holes [ ] Other (Specify) [ ] Louvered Shutter [ ] Key Punched [ ] Wire Wrapped [ ] Saw Cut [ ] None (Open Hole)

SCREEN-PERFORATED INTERVALS: From 40 ft. to 100 ft., From ft. to ft., From ft. to ft. GRAVEL PACK INTERVALS: From 24 ft. to 100 ft., From ft. to ft., From ft. to ft.

9 GROUT MATERIAL: [ ] Neat cement [ ] Cement grout [x] Bentonite [ ] Other Grout intervals: From 4 ft. to 24 ft., From ft. to ft., From ft. to ft.

Nearest source of possible contamination: [x] No potential source of contamination within 200 ft. [ ] Septic Tank [ ] Lateral Lines [ ] Pit Privy [ ] Livestock Pens [ ] Insecticide Storage [ ] Sewer Lines [ ] Cess Pool [ ] Sewage Lagoon [ ] Fuel Storage [ ] Abandoned Water Well [ ] Watertight Sewer Lines [ ] Seepage Pit [ ] Feedyard [ ] Fertilizer Storage [ ] Oil Well/Gas Well [ ] Other (Specify) Direction from well? Distance from well? ft.

10 FROM TO LITHOLOGIC LOG FROM TO LITHO. LOG (cont.) or PLUGGING INTERVALS

0	3	TOP SOIL			
3	17	CLAY			
17	51	GREEN SHALE			
51	96	SHALE			
96	100	LIMESTONE			

Notes:

11 CONTRACTOR'S OR LANDOWNER'S CERTIFICATION: This water well was [x] constructed, [ ] reconstructed, or [ ] plugged under my jurisdiction and was completed on (mo-day-year) 02/01/2022 and this record is true to the best of my knowledge and belief. Kansas Water Well Contractor's License No. 611 This Water Well Record was completed on (mo-day-year) 02/15/2022 under the business name of Chase Drilling