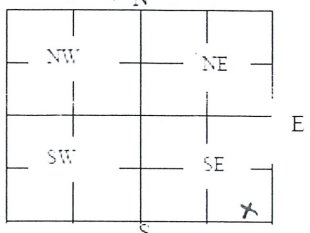


WATER WELL PLUGGING RECORD Form WWC-5P KSA 82a-1212 ID NO.

<b>1 LOCATION OF WATER WELL:</b> County: <u>Butler</u> Street/Rural Address of Well Location: if unknown, distance & direction from nearest town or intersection: If at owner's address, check here <input type="checkbox"/> <u>Prairie Creek &amp; NW 120th</u> <u>1/4 mile west</u>	Fraction <u>SW 1/4 SE 1/4</u> Section Number <u>5</u> Township Number <u>T. 24-S</u> Range Number <u>3</u> <input checked="" type="checkbox"/> E <input type="checkbox"/> W	Global Positioning Systems (GPS) information: Latitude: <u>37.7863685</u> (in decimal degrees) Longitude: <u>-97.1260872</u> (in decimal degrees) Elevation: <u>430.5967683 M</u> <u>Google Earth</u> Horizontal Datum: <input type="checkbox"/> WGS84 <input type="checkbox"/> NAD83 <input type="checkbox"/> NAD27 Collection Method: _____ <input type="checkbox"/> GPS unit (Make/Model: _____) <input checked="" type="checkbox"/> Digital Map Photo <input type="checkbox"/> Topographic Map <input type="checkbox"/> Land Survey Est. Accuracy: <input type="checkbox"/> < 3 m <input type="checkbox"/> 3-5 m <input checked="" type="checkbox"/> 5-15 m <input type="checkbox"/> > 15 m																		
<b>2 WATER WELL OWNER:</b> <u>Russell Entz</u> RR#, St. Address, Box #: <u>11739 NW Prairie Creek Rd.</u> City, State ZIP Code: <u>Whitewater KS 67154</u>	<b>3 MARK WELL'S LOCATION WITH AN "X" IN SECTION BOX:</b> <div style="text-align: center;">  </div>																			
<b>4 DEPTH OF WELL</b> <u>54</u> ft. <b>WELL'S STATIC WATER LEVEL</b> <u>29</u> ft. <b>WELL WAS USED AS:</b> <div style="display: flex; justify-content: space-between;"> <div> <input checked="" type="checkbox"/> Domestic  <input type="checkbox"/> Irrigation  <input type="checkbox"/> Feedlot  <input type="checkbox"/> Industrial         </div> <div> <input type="checkbox"/> Public Water Supply  <input type="checkbox"/> Oil Field Water Supply  <input type="checkbox"/> Domestic (Lawn &amp; Garden)  <input type="checkbox"/> Air Conditioning         </div> <div> <input type="checkbox"/> Dewatering  <input type="checkbox"/> Monitoring  <input type="checkbox"/> Injection Well  <input type="checkbox"/> Other _____         </div> </div> Was a chemical/bacteriological sample submitted to Department? Yes <input type="checkbox"/> No <input checked="" type="checkbox"/>																				
<b>5 TYPE OF BLANK CASING USED:</b> <div style="display: flex; justify-content: space-between;"> <div> <input type="checkbox"/> Steel  <input checked="" type="checkbox"/> PVC         </div> <div> <input type="checkbox"/> RMP (SR)  <input type="checkbox"/> ABS         </div> <div> <input type="checkbox"/> Wrought  <input type="checkbox"/> Asbestos-Cement         </div> <div> <input type="checkbox"/> Fiberglass  <input type="checkbox"/> Concrete Tile         </div> <div> <input type="checkbox"/> Other (Specify below) _____         </div> </div> Blank casing diameter <u>6</u> in. Was casing pulled? Yes <input checked="" type="checkbox"/> No <input type="checkbox"/> If yes, how much <u>4 ft.</u> Casing height above or below land surface _____ in. <u>4 ft below</u>																				
<b>6 GROUT PLUG MATERIAL:</b> <input type="checkbox"/> Neat cement <input type="checkbox"/> Cement grout <input checked="" type="checkbox"/> Bentonite <input type="checkbox"/> Other _____ Grout Plug Intervals: From <u>4</u> ft. to <u>8</u> ft. From _____ ft. to _____ ft. From _____ ft. to _____ ft. What is the nearest source of possible contamination: <u>In the middle of a crop field.</u> <div style="display: flex; justify-content: space-between;"> <div> <input type="checkbox"/> Septic tank  <input type="checkbox"/> Sewer lines  <input type="checkbox"/> Watertight sewer lines  <input type="checkbox"/> Lateral lines  <input type="checkbox"/> Cess pool         </div> <div> <input type="checkbox"/> Seepage pit  <input type="checkbox"/> Pit privy  <input type="checkbox"/> Sewage lagoon  <input type="checkbox"/> Feedyard  <input type="checkbox"/> Livestock pens         </div> <div> <input type="checkbox"/> Fuel storage  <input type="checkbox"/> Fertilizer storage  <input type="checkbox"/> Insecticide storage  <input type="checkbox"/> Abandoned water well  <input type="checkbox"/> Oil well/Gas well         </div> <div> <input type="checkbox"/> Other (specify below) _____          Direction from well? _____          How many feet? _____         </div> </div> <table border="1" style="width:100%; border-collapse: collapse; margin-top: 10px;"> <thead> <tr> <th>FROM</th> <th>TO</th> <th>PLUGGING MATERIALS</th> </tr> </thead> <tbody> <tr> <td><u>4</u></td> <td><u>8</u></td> <td><u>Bentonite</u></td> </tr> <tr> <td><u>54</u></td> <td><u>27</u></td> <td><u>Clorox/Sand</u></td> </tr> <tr> <td><u>27</u></td> <td><u>8</u></td> <td><u>Subsoil</u></td> </tr> <tr> <td><u>8</u></td> <td><u>4</u></td> <td><u>Bentonite</u></td> </tr> <tr> <td><u>4</u></td> <td><u>0</u></td> <td><u>Topsoil</u></td> </tr>
<b>7 CONTRACTOR'S OR LANDOWNER'S CERTIFICATION:</b> This water well was plugged under my jurisdiction and was completed on (mo/day/year) <u>3/18/23</u> and this record is true to the best of my knowledge and belief. Kansas Water Well Contractor's License No. _____ This Water Well Record was completed on (mo/day/year) <u>3/26/23</u> under the business name of <u>Russell Entz</u> by (signature) <u>Russell Entz</u>																				
Send one white copy to Kansas Department of Health & Environment, Geology Section, 1000 SW Jackson Street, Ste. 420, Topeka, KS 66612-1367. Send one copy to WATER WELL OWNER and retain one for your records. Visit us at <a href="http://www.kdheks.gov/waterwell/index.html">http://www.kdheks.gov/waterwell/index.html</a> Telephone 785-296-5524.																				