


1 LOCATION OF WATER WELL: Fraction no 1/4 no 1/4 SW 1/4 Section Number 22 Township Number T 24 S Range Number R 3 E/N
 County: Butler

Distance and direction from nearest town or city street address of well if located within city?
2 1/2 E Whitewater on 196

2 WATER WELL OWNER: AG Service
 RR#, St. Address, Box #: R2 Box 192A Board of Agriculture, Division of Water Resources
 City, State, ZIP Code: Hillsboro, KS, 67063 Application Number:

3 LOCATE WELL'S LOCATION WITH AN "X" IN SECTION BOX:

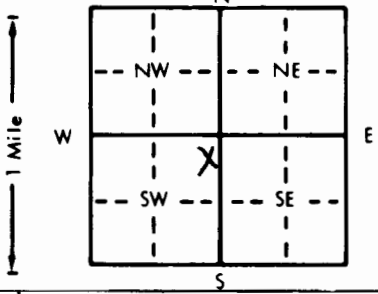

4 DEPTH OF COMPLETED WELL: 88 ft. ELEVATION:

Depth(s) Groundwater Encountered 1 32 78 ft. 2. ft. 3. ft.
 WELL'S STATIC WATER LEVEL 32 ft. below land surface measured on mo/day/yr 3-23-95

Pump test data: Well water was _____ ft. after _____ hours pumping _____ gpm
 Est. Yield 25 gpm; Well water was _____ ft. after _____ hours pumping _____ gpm

Bore Hole Diameter: 8 1/2 in. to 8 1/2 ft., and _____ in. to _____ ft.

WELL WATER TO BE USED AS:
 1 Domestic 1 3 Feedlot 6 Oil field water supply 9 Dewatering 12 Other (Specify below)
 2 Irrigation 4 Industrial 7 Lawn and garden only 10 Monitoring well

Was a chemical/bacteriological sample submitted to Department? Yes _____ No X; If yes, mo/day/yr sample was submitted _____
 Water Well Disinfected? Yes X No

5 TYPE OF BLANK CASING USED:
 1 Steel 3 RMP (SR) 5 Wrought iron 8 Concrete tile CASING JOINTS: Glued X Clamped _____
 2 PVC 4 ABS 6 Asbestos-Cement 9 Other (specify below) Welded _____
 7 Fiberglass Threaded _____

Blank casing diameter 5 in. to 6 1/2 ft., Dia _____ in. to _____ ft., Dia _____ in. to _____ ft.
 Casing height above land surface 12 in., weight SDR 26 lbs./ft. Wall thickness or gauge No. 214

TYPE OF SCREEN OR PERFORATION MATERIAL:
 1 Steel 3 Stainless steel 5 Fiberglass 8 RMP (SR) 10 Asbestos-cement 11 Other (specify) _____
 2 Brass 4 Galvanized steel 6 Concrete tile 9 ABS 12 None used (open hole)

SCREEN OR PERFORATION OPENINGS ARE:
 1 Continuous slot 3 Mill slot 5 Gauzed wrapped 8 Saw cut 11 None (open hole)
 2 Louvered shutter 4 Key punched 6 Wire wrapped 9 Drilled holes 10 Other (specify) _____

SCREEN-PERFORATED INTERVALS: From 60 ft. to 88 ft., From _____ ft. to _____ ft.
 From _____ ft. to _____ ft., From _____ ft. to _____ ft.

GRAVEL PACK INTERVALS: From 20 ft. to 88 ft., From _____ ft. to _____ ft.
 From _____ ft. to _____ ft., From _____ ft. to _____ ft.

6 GROUT MATERIAL: 1 Neat cement 20 Cement grout 3 Bentonite 4 Other _____
 Grout Intervals: From 0 ft. to 20 ft., From _____ ft. to _____ ft., From _____ ft. to _____ ft.

What is the nearest source of possible contamination:
 1 Septic tank 4 Lateral lines 7 Pit privy 10 Livestock pens 14 Abandoned water well
 2 Sewer lines 5 Cess pool 8 Sewage lagoon 11 Fuel storage 15 Oil well/Gas well
 3 Watertight sewer lines 6 Seepage pit 9 Feedyard 12 Fertilizer storage 16 Other (specify below)
 13 Insecticide storage

Direction from well? W How many feet? 100 +

FROM	TO	LITHOLOGIC LOG	FROM	TO	PLUGGING INTERVALS
0	4	Clay			
4	6	Soft lime			
6	12	Brown Clay			
12	78	Yellow Shale			
78	79	Water			
79	88	Blue Shale			

7 CONTRACTOR'S OR LANDOWNER'S CERTIFICATION: This water well was (1) constructed, (2) reconstructed, or (3) plugged under my jurisdiction and was completed on (mo/day/year) 3-23-95 and this record is true to the best of my knowledge and belief. Kansas Water Well Contractor's License No. 120 This Water Well Record was completed on (mo/day/yr) 4-10-95 under the business name of Backhus Drilling by (signature) J. Backhus