


1 LOCATION OF WATER WELL: Fraction Section Number Township Number Range Number
 County: Butler SE 1/4 SE 1/4 SE 1/4 33 T 24 S R 4 EW

Distance and direction from nearest town or city street address of well if located within city?
 From the SE corner of Sec. 33, 528' N; 282' W/

2 WATER WELL OWNER: David Dysinger
 RR#, St. Address, Box # : Rt 4 Box 90A Board of Agriculture, Division of Water Resources
 City, State, ZIP Code : Potwin, Ks. 67123 Application Number:

3 LOCATE WELL'S LOCATION WITH AN "X" IN SECTION BOX:

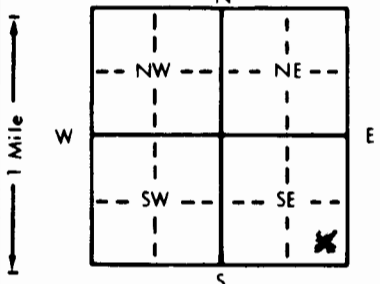

4 DEPTH OF COMPLETED WELL: 60 ft. ELEVATION:

Depth(s) Groundwater Encountered 1. 41 ft. 2. ft. 3. ft.
 WELL'S STATIC WATER LEVEL 28 ft. below land surface measured on mo/day/yr 3/19/96
 Pump test data: Well water was ft. after hours pumping gpm
 Est. Yield 6 gpm: Well water was ft. after hours pumping gpm
 Bore Hole Diameter 10 in. to 60 ft., and in. to ft.
 WELL WATER TO BE USED AS: 5 Public water supply 8 Air conditioning 11 Injection well
1 Domestic 3 Feedlot 6 Oil field water supply 9 Dewatering 12 Other (Specify below)
2 Irrigation 4 Industrial 7 Lawn and garden only 10 Monitoring well
 Was a chemical/bacteriological sample submitted to Department? Yes No X; If yes, mo/day/yr sample was submitted
 Water Well Disinfected? Yes X No

5 TYPE OF BLANK CASING USED: 5 Wrought iron 8 Concrete tile CASING JOINTS Glued Clamped

1 Steel 3 RMP (SR) 6 Asbestos-Cement 9 Other (specify below) Welded
2 PVC 4 ABS 7 Fiberglass Threaded
 Blank casing diameter 5 in. to 30 ft., Dia in. to ft., Dia in. to ft.
 Casing height above land surface 18 in., weight 160 lbs./ft. Wall thickness or gauge No.

TYPE OF SCREEN OR PERFORATION MATERIAL: 7 PVC 10 Asbestos-cement
 1 Steel 3 Stainless steel 5 Fiberglass 8 RMP (SR) 11 Other (specify)
 2 Brass 4 Galvanized steel 6 Concrete tile 9 ABS 12 None used (open hole)

SCREEN OR PERFORATION OPENINGS ARE: 5 Gauzed wrapped 8 Saw cut 11 None (open hole)
 1 Continuous slot 3 Mill slot 6 Wire wrapped 9 Drilled holes
 2 Louvered shutter 4 Key punched 7 Torch cut 10 Other (specify)

SCREEN-PERFORATED INTERVALS: From 30 ft. to 60 ft., From ft. to ft.
 From ft. to ft., From ft. to ft.
 GRAVEL PACK INTERVALS: From 25 ft. to 60 ft., From ft. to ft.
 From ft. to ft., From ft. to ft.

6 GROUT MATERIAL: 1 Neat cement 2 Cement grout 3 Bentonite 4 Other

Grout intervals: From 23 ft. to 19 (2) ft., From 19 ft. to 3 (3) ft., From ft. to ft.
 What is the nearest source of possible contamination:
 1 Septic tank 4 Lateral lines 7 Pit privy 10 Livestock pens 14 Abandoned water well
 2 Sewer lines 5 Cess pool 8 Sewage lagoon 11 Fuel storage 15 Oil well/Gas well
 3 Watertight sewer lines 6 Seepage pit 9 Feedyard 12 Fertilizer storage 16 Other (specify below)
 13 Insecticide storage

Direction from well? North How many feet? 400+

FROM	TO	LITHOLOGIC LOG	FROM	TO	PLUGGING INTERVALS
0.0	4.0	Top Soil			
4.0	15.0	Yellow gray shale			
15.0	17.0	Yellow gray limestone			
17.0	25.0	Yellow gray shale			
25.0	30.0	Reddish brown shale with green shale inclusions			
30.0	41.0	Gray shale			
41.0	42.0	Yellow gray limestone			
42.0	47.0	Gray shale			
47.0	48.0	Yellow gray limestone			
48.0	60.0	Gray shale			

7 CONTRACTOR'S OR LANDOWNER'S CERTIFICATION: This water well was (1) constructed, (2) reconstructed, or (3) plugged under my jurisdiction and was completed on (mo/day/year) 3/19/96 and this record is true to the best of my knowledge and belief. Kansas Water Well Contractor's License No. 279 This Water Well Record was completed on (mo/day/yr) 3/20/96 under the business name of Fudge Drilling by (signature) Mehrin R. Fudge