


1 LOCATION OF WATER WELL: Fraction SE 1/4 NE 1/4 SW 1/4 Section Number 18 Township Number T 24 S Range Number R 4 E  
 County: Butler

Distance and direction from nearest town or city street address of well if located within city?  
1 Mile N + 1 Mile W of Pat. Win. Kan

2 WATER WELL OWNER: Kendal Chason Whitewater 67154  
 RR#, St. Address, Box # : 10069 NW Adams Rd Board of Agriculture, Division of Water Resources  
 City, State, ZIP Code : Rel Application Number:

3 LOCATE WELL'S LOCATION WITH AN "X" IN SECTION BOX: 4 DEPTH OF COMPLETED WELL 147 ft. ELEVATION:

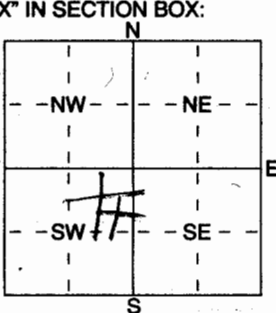

Depth(s) Groundwater Encountered 1 30 ft. 2 90 ft. 3 90 ft.  
 WELL'S STATIC WATER LEVEL 30 ft. below land surface measured on mo/day/yr  
 Pump test data: Well water was 30 ft. after 20 hours pumping 20 gpm  
 Est. Yield 20 gpm: Well water was 30 ft. after 20 hours pumping 20 gpm  
 WELL WATER TO BE USED AS:  
 Domestic 3 Feedlot 6 Oil field water supply 9 Dewatering 12 Other (Specify below)  
 Irrigation 4 Industrial 7 Domestic (lawn & garden) 10 Monitoring well

Was a chemical/bacteriological sample submitted to Department? Yes No No X; If yes, mo/day/yr sample was submitted  
 Water Well Disinfected? Yes X No

5 TYPE OF BLANK CASING USED:  
 1 Steel 3 RMP (SR) 5 Wrought iron 8 Concrete tile CASING JOINTS: Glued X Clamped  
 PVC 4 ABS 7 Fiberglass 9 Other (specify below) Welded  
 Blank casing diameter 5 in. to 50 ft., Dia 18 in. to 160 lbs./ft. Wall thickness or guage No 214  
 Casing height above land surface 18 in., weight 160 lbs./ft. Wall thickness or guage No 214

TYPE OF SCREEN OR PERFORATION MATERIAL:  
 1 Steel 3 Stainless Steel 5 Fiberglass  PVC 10 Asbestos-Cement  
 2 Brass 4 Galvanized Steel 6 Concrete tile 8 RMP (SR) 11 Other (Specify)  
 9 ABS 12 None used (open hole)

SCREEN OR PERFORATION OPENINGS ARE:  
 1 Continuous slot 3 Mill slot 5 Gauzed wrapped  Saw cut 11 None (open hole)  
 2 Louvered shutter 4 Key punched 6 Wire wrapped 9 Drilled holes  
 7 Torch cut 10 Other (specify) ft.

SCREEN-PERFORATED INTERVALS: From 50 ft. to 147 ft., From 50 ft. to 147 ft.  
 GRAVEL PACK INTERVALS: From 50 ft. to 147 ft., From 50 ft. to 147 ft.

6 GROUT MATERIAL: 1 Neat cement 2 Cement grout  Bentonite 4 Other  
 Grout Intervals: From 3 ft. to 23 ft., From 3 ft. to 23 ft.

What is the nearest source of possible contamination:  
 1 Septic tank 4 Lateral lines 7 Pit privy 10 Livestock pens 14 Abandoned water well  
 2 Sewer lines 5 Cess pool  Sewage lagoon 11 Fuel storage 15 Oil well/Gas well  
 3 Watertight sewer lines 6 Seepage pit 9 Feedyard 12 Fertilizer storage 16 Other (specify below)  
 13 Insecticide storage

Direction from well? SE How many feet? 200

FROM	TO	LITHOLOGIC LOG	FROM	TO	PLUGGING INTERVALS
0	1	SOIL			
1	18	Rock			
18	35	Clay			
35	148	Shale + lime			

7 CONTRACTOR'S OR LANDOWNER'S CERTIFICATION: This water well was  constructed,  reconstructed, or  plugged under my jurisdiction and was completed on (mo/day/year) 12/10/04 and this record is true to the best of my knowledge and belief. Kansas Water Well Contractor's Licence No 72154 This Water Well Record was completed on (mo/day/yr) 12/10/04 under the business name of Winter Well Drilling by (signature) Charles Winter