


1 LOCATION OF WATER WELL: County: **Butler** Fraction: **SE 1/4 NW 1/4 NE 1/4** Section Number: **9** Township Number: **T 24 S** Range Number: **R 4 E**

Distance and direction from nearest town or city street address of well if located within city? **3-E & 3 N of Potwin**

2 WATER WELL OWNER: **Melvin Busnitz** **Potwin Kan 67123**  
 RR#, St. Address, Box # : **8831 NW Hopkins** Board of Agriculture, Division of Water Resources  
 City, State, ZIP Code : **switch** Application Number:

3 LOCATE WELL'S LOCATION WITH AN "X" IN SECTION BOX: 4 DEPTH OF COMPLETED WELL: **150** ft. ELEVATION:

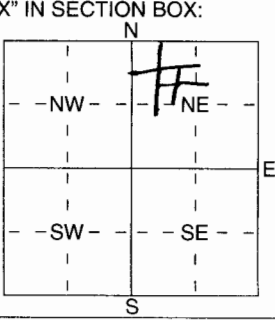

Depth(s) Groundwater Encountered: 1 **90** ft. 2 ..... ft. 3 ..... ft.  
 WELL'S STATIC WATER LEVEL: **30** ft. below land surface measured on mo/day/yr .....  
 Pump test data: Well water was ..... ft. after ..... hours pumping ..... gpm  
 Est. Yield: **50** gpm: Well water was ..... ft. after ..... hours pumping ..... gpm  
 WELL WATER TO BE USED AS:  
 1 Domestic    3 Feedlot    6 Oil field water supply    9 Dewatering    12 Other (Specify below)  
 2 Irrigation    4 Industrial    7 Domestic (lawn & garden)    10 Monitoring well

Was a chemical/bacteriological sample submitted to Department? Yes ..... No **X**; If yes, mo/day/yr sample was submitted  
 Water Well Disinfected? Yes **X** No

5 TYPE OF BLANK CASING USED:  
 1 Steel    3 RMP (SR)    5 Wrought iron    8 Concrete tile    CASING JOINTS: Glued **X** Clamped .....  
 2 PVC    4 ABS    6 Asbestos-Cement    9 Other (specify below)    Welded .....  
 7 Fiberglass    Threaded .....

Blank casing diameter: **5** in. to **50** ft., Dia ..... in. to ..... ft., Dia ..... in. to ..... ft.  
 Casing height above land surface: **18** in., weight **160** lbs./ft. Wall thickness or gauge No. **124**

TYPE OF SCREEN OR PERFORATION MATERIAL:  
 1 Steel    3 Stainless Steel    5 Fiberglass    8 RMP (SR)    10 Asbestos-Cement  
 2 Brass    4 Galvanized Steel    6 Concrete tile    9 ABS    11 Other (Specify) .....  
 12 None used (open hole)

SCREEN OR PERFORATION OPENINGS ARE:  
 1 Continuous slot    3 Mill slot    5 Gauzed wrapped    8 Saw cut    11 None (open hole)  
 2 Louvered shutter    4 Key punched    6 Wire wrapped    9 Drilled holes  
 7 Torch cut    10 Other (specify) ..... ft.

SCREEN-PERFORATED INTERVALS: From **50** ft. to **150** ft., From ..... ft. to ..... ft.  
 GRAVEL PACK INTERVALS: From ..... ft. to ..... ft., From ..... ft. to ..... ft.

6 GROUT MATERIAL:  1 Neat cement     2 Cement grout     3 Bentonite     4 Other .....  
 Grout Intervals: From **3** ft. to **23** ft., From ..... ft. to ..... ft., From ..... ft. to ..... ft.

What is the nearest source of possible contamination:  
 1 Septic tank    4 Lateral lines    7 Pit privy    10 Livestock pens    14 Abandoned water well  
 2 Sewer lines    5 Cess pool    8 Sewage lagoon    11 Fuel storage    15 Oil well/Gas well  
 3 Watertight sewer lines    6 Seepage pit    9 Feedyard    12 Fertilizer storage    16 Other (specify below)  
 13 Insecticide storage

Direction from well? **NW** How many feet? **150**

| FROM      | TO         | LITHOLOGIC LOG          | FROM | TO | PLUGGING INTERVALS |
|-----------|------------|-------------------------|------|----|--------------------|
| <b>0</b>  | <b>4</b>   | <b>soil</b>             |      |    |                    |
| <b>4</b>  | <b>10</b>  | <b>clay</b>             |      |    |                    |
| <b>10</b> | <b>15</b>  | <b>rock</b>             |      |    |                    |
| <b>15</b> | <b>30</b>  | <b>clay</b>             |      |    |                    |
| <b>30</b> | <b>150</b> | <b>shale &amp; lime</b> |      |    |                    |

7 CONTRACTOR'S OR LANDOWNER'S CERTIFICATION: This water well was  (1) constructed, (2) reconstructed, or (3) plugged under my jurisdiction and was completed on (mo/day/year) **12/1/05** and this record is true to the best of my knowledge and belief. Kansas Water Well Contractor's Licence No. **251** This Water Well Record was completed on (mo/day/year) **12/30/05** under the business name of **Winter Well Drilling** by (signature) **Charles Winter**