


1 LOCATION OF WATER WELL:	Fraction	Section Number	Township Number	Range Number
County: <b>Butler</b>	<b>SW 1/4 NE 1/4 NE 1/4</b>	<b>30</b>	<b>T 24 S</b>	<b>R 4</b> (E/W)

Distance and direction from nearest town or city street address of well if located within city?  
 ~750'E of intersect. K196 & Whitewater Ave, Potwin

2 WATER WELL OWNER:	MRP Properties Company, LLC	Lubrication Engineers, Inc.	Board of Agriculture, Division of Water Resources
RR#, St. Address, Box #	PO Box 696000	1919 East Tulsa	Application Number:
City, State, ZIP Code	San Antonio, TX 76269-6000	Wichita, KS 67216	

3 LOCATE WELL'S LOCATION WITH AN "X" IN SECTION BOX:

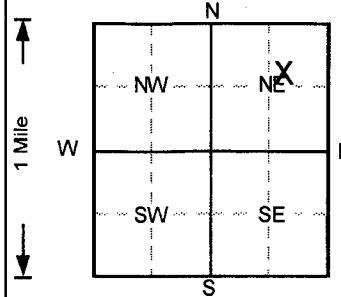

4 DEPTH OF COMPLETED WELL	47	ft. ELEVATION:	
Depth(s) Groundwater Encountered	1. . . . . ft.	2. . . . . ft.	3. . . . . ft.
WELL'S STATIC WATER LEVEL	. . . . . ft. below land surface measured on mo/day/yr		
Pump test data: Well water was	NA	ft. after . . . . . hours pumping	. . . . . gpm
Est. Yield	NA	gpm: Well water was	. . . . . ft. after . . . . . hours pumping . . . . . gpm
Bore Hole Diameter	5.75	in. to . . . . . 48	ft. and . . . . . in. to . . . . . ft.
WELL WATER TO BE USED AS:	5 Public water supply     8 Air conditioning     11 Injection well 1 Domestic     3 Feedlot     6 Oil field water supply     9 Dewatering     12 Other (Specify below) 2 Irrigation     4 Industrial     7 Lawn and garden only <b>10</b> Monitoring well		
Was a chemical/bacteriological sample submitted to Department?	Yes . . . . . No <input checked="" type="checkbox"/>	If yes, mo/day/yr sample was submitted	
Water Well Disinfected?	Yes	No <input checked="" type="checkbox"/>	

5 TYPE OF BLANK CASING USED:	5 Wrought iron	8 Concrete tile	CASING JOINTS: Glued . . . . . Clamped . . . . .
1 Steel	3 RMP (SR)	6 Asbestos-Cement	9 Other (specify below)
<b>2</b> PVC	4 ABS	7 Fiberglass	Welded . . . . .
Blank casing diameter	2	in. to . . . . . 37	ft. Dia . . . . . in. to . . . . . ft. Dia . . . . . in. to . . . . . ft.
Casing height above land surface	2.38	in., weight . . . . . lbs./ft.	Wall thickness or gauge No. . . . . Sch. 40
TYPE OF SCREEN OR PERFORATION MATERIAL	<b>7</b> PVC     10 Asbestos-cement		
1 Steel	3 Stainless steel	5 Fiberglass	<b>8</b> RMP (SR)     11 Other (specify) . . . . .
2 Brass	4 Galvanized steel	6 Concrete tile	9 ABS     12 None used (open hole)
SCREEN OR PERFORATION OPENINGS ARE:	5 Gauzed wrapped	8 Saw cut	11 None (open hole)
1 Continuous slot	<b>3</b> Mill slot	6 Wire wrapped	9 Drilled holes
2 Louvered shutter	4 Key punched	7 Torch cut	10 Other (specify) . . . . .
SCREEN-PERFORATED INTERVALS:	From . . . . . 37	ft. to . . . . . 47	ft. From . . . . . ft. to . . . . . ft.
	From . . . . . ft. to . . . . . ft.	From . . . . . ft. to . . . . . ft.	From . . . . . ft. to . . . . . ft.
GRAVEL PACK INTERVALS:	From . . . . . 35	ft. to . . . . . 47	ft. From . . . . . ft. to . . . . . ft.
	From . . . . . ft. to . . . . . ft.	From . . . . . ft. to . . . . . ft.	From . . . . . ft. to . . . . . ft.

6 GROUT MATERIAL:	1 Neat cement	2 Cement grout	<b>3</b> Bentonite	4 Other . . . . .
Grout Intervals:	From . . . . . 0.5	ft. to . . . . . 35	ft. From . . . . . ft. to . . . . . ft.	From . . . . . ft. to . . . . . ft.
What is the nearest source of possible contamination:	1 Septic tank     4 Lateral lines     7 Pit privy     10 Livestock pens     14 Abandoned water well 2 Sewer lines     5 Cess pool     8 Sewage lagoon     11 Fuel storage     15 Oil well/Gas well 3 Watertight sewer lines     6 Seepage pit     9 Feedyard     12 Fertilizer storage     16 Other (specify below) 13 Insecticide storage			
Direction from well?	How many feet?			

FROM	TO	LITHOLOGIC LOG	FROM	TO	PLUGGING INTERVALS
0	7	Clay, Brown			
7	24.7	Clay, coarse sand to gravel, Brown			
24.7	25.8	Limestone,			
25.8	31.3	Shale, Tan and Gray			
31.3	39.6	Shale, Dark Gray			
39.6	45	Shale and Limestone,			
45	47.9	Shale, Green			
47.9	50	Shale, Brick Red			
					SCIMW-01(S) , Abovegrade

7 CONTRACTOR'S OR LANDOWNER'S CERTIFICATION:	This water well was <b>1</b> constructed, <b>(2)</b> reconstructed, or <b>(3)</b> plugged under my jurisdiction	
and was completed on (mo/day/year)	8/3/2009	and this record is true to the best of my knowledge and belief.
Kansas Water Well Contractor's License No.	527	This Water Well Record was completed on (mo/day/yr)
under the business name of	GeoCore, Inc.	by (signature) <i>Dale Rabey</i>

INSTRUCTIONS: Use typewriter or ball point pen. PLEASE PRESS FIRMLY and PRINT clearly. Please fill in blanks, underline or circle the correct answers. Send top three copies to Kansas Department of Health and Environment, Bureau of Water, Topeka, Kansas 66620-0001. Telephone: 913-296-5545. Send one to WATER WELL OWNER and retain one for your records.

OFFICE USE ONLY  
 T  
 R  
 EW  
 SEC.  
 1/4  
 1/4