


1 LOCATION OF WATER WELL:	Fraction	Section Number	Township Number	Range Number
County: <b>Butler</b>	<b>NW ¼ SW ¼ NW ¼</b>	<b>29</b>	<b>T 24 S</b>	<b>R 4</b> <b>(E)N</b>

Distance and direction from nearest town or city street address of well if located within city?

~200' NW of so. bend in Kellogg Ave., Potwin

2 WATER WELL OWNER:	MRP Properties Company, LLC PO Box 696000 San Antonio, TX 76269-6000	Lubrication Engineers, Inc. 1919 East Tulsa Wichita, KS 67216	Board of Agriculture, Division of Water Resources Application Number:
---------------------	--	---	--

3 LOCATE WELL'S LOCATION WITH AN "X" IN SECTION BOX:

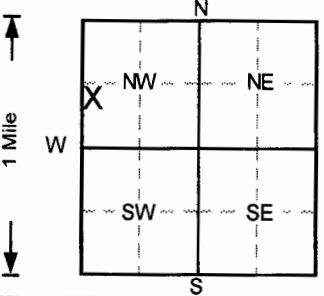

4 DEPTH OF COMPLETED WELL ..... **58** ..... ft. ELEVATION: .....

Depth(s) Groundwater Encountered 1. .... ft. 2. .... ft. 3. .... ft.

WELL'S STATIC WATER LEVEL ..... ft. below land surface measured on mo/day/yr .....

Pump test data: Well water was ..... **NA** ..... ft. after ..... hours pumping ..... gpm

Est. Yield .. **NA** .. gpm: Well water was ..... ft. after ..... hours pumping ..... gpm

Bore Hole Diameter ... **9.75** ... in. to ... **39** ..... ft., and ... **5.75** ..... in. to ... **59** ..... ft.

WELL WATER TO BE USED AS: 5 Public water supply 8 Air conditioning 11 Injection well

1 Domestic 3 Feedlot 6 Oil field water supply 9 Dewatering 12 Other (Specify below)

2 Irrigation 4 Industrial 7 Lawn and garden only **10** Monitoring well

Was a chemical/bacteriological sample submitted to Department? Yes.....No  : If yes, mo/day/yr sample was submitted

Water Well Disinfected? Yes No

5 TYPE OF BLANK CASING USED:

1 Steel	3 RMP (SR)	5 Wrought iron	8 Concrete tile	CASING JOINTS: Glued ..... Clamped .....
<b>2</b> PVC	4 ABS	6 Asbestos-Cement	9 Other (specify below)	Welded .....
		7 Fiberglass		Threaded. <input checked="" type="checkbox"/>

Blank casing diameter ..... **6** ..... in. to ..... **39** ..... ft., Dia ..... **2** ..... in. to ..... **48** ..... ft., Dia ..... in. to ..... ft.

Casing height above land surface ..... in., weight ..... lbs./ft. Wall thickness or gauge No. .... **Sch. 40** .....

TYPE OF SCREEN OR PERFORATION MATERIAL

1 Steel	3 Stainless steel	5 Fiberglass	<b>7</b> PVC	10 Asbestos-cement
2 Brass	4 Galvanized steel	6 Concrete tile	8 RMP (SR)	11 Other (specify) .....
			9 ABS	12 None used (open hole)

SCREEN OR PERFORATION OPENINGS ARE:

1 Continuous slot	<b>3</b> Mill slot	5 Gauzed wrapped	8 Saw cut	11 None (open hole)
2 Louvered shutter	4 Key punched	6 Wire wrapped	9 Drilled holes	
		7 Torch cut	10 Other (specify) .....	

SCREEN-PERFORATED INTERVALS: From ..... **48** ..... ft. to ..... **58** ..... ft., From ..... ft. to ..... ft.

GRAVEL PACK INTERVALS: From ..... **45** ..... ft. to ..... **59** ..... ft., From ..... ft. to ..... ft.

6 GROUT MATERIAL: 1 Neat cement 2 Cement grout **3** Bentonite 4 Other .....

Grout Intervals: From ..... **0.5** ..... ft. to ..... **45** ..... ft., From ..... ft. to ..... ft.

What is the nearest source of possible contamination:

1 Septic tank	4 Lateral lines	7 Pit privy	10 Livestock pens	14 Abandoned water well
2 Sewer lines	5 Cess pool	8 Sewage lagoon	11 Fuel storage	15 Oil well/Gas well
3 Watertight sewer lines	6 Seepage pit	9 Feedyard	12 Fertilizer storage	16 Other (specify below)
			13 Insecticide storage	

Direction from well? How many feet?

FROM	TO	LITHOLOGIC LOG	FROM	TO	PLUGGING INTERVALS
0	0.4	Clay, Brown	97	100	Shale, Red
0.4	4.2	Limestone and Shale, clayey gravel			
4.2	6.4	Shale, Tan			
6.4	12.5	Limestone, Tan to Gray			
12.5	25	Shale, Tan w/gray laminations			
25	25.9	Limestone, dolomitic, Lt. Gray			
25.9	27.8	Shale, Tan and Gray			
27.8	28.5	Limestone,			
28.5	38	Shale, Lt. Olive w/tan			
38	42.6	Shale, Brick Red			
42.6	55	Shale, Tan to Gray			
55	58.8	Shale, Black			
58.8	80.7	Limestone, Gray			SCIMW-12(D), Abovegrade
80.7	85.2	Shale and Mudstone, Dark Gray			
85.2	97	Shale, Lt. Gray			

7 CONTRACTOR'S OR LANDOWNER'S CERTIFICATION: This water well was **(1)** constructed, (2) reconstructed, or (3) plugged under my jurisdiction and was completed on (mo/day/year) ..... **7/30/2009** ..... and this record is true to the best of my knowledge and belief.

Kansas Water Well Contractor's License No. .... **527** ..... This Water Well Record was completed on (mo/day/yr) ..... **8/28/2009** .....

under the business name of **GeoCore, Inc.** by (signature) *Dan Kelly*

OFFICE USE ONLY  
T  
R  
EW  
SEC.  
1/4  
1/4  
1/4