


1 LOCATION OF WATER WELL: County: **Butler** Fraction: **NE 1/4 SE 1/4 NE 1/4** Section Number: **30** Township Number: **T 24 S** Range Number: **R 4 E/W**

Distance and direction from nearest town or city street address of well if located within city?

~250' N of west pond between K196 & Powell, Potwin

2 WATER WELL OWNER: MRP Properties Company, LLC Lubrication Engineers, Inc.
 RR# St. Address, Box # : PO Box 696000 1919 East Tulsa
 City, State, ZIP Code : San Antonio, TX 76269-6000 Wichita, KS 67216
 Board of Agriculture, Division of Water Resources
 Application Number:

3 LOCATE WELL'S LOCATION WITH AN "X" IN SECTION BOX:

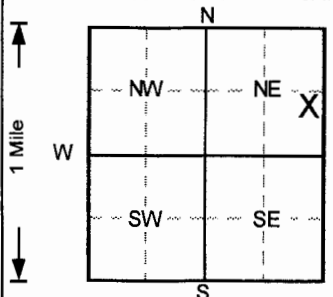

4 DEPTH OF COMPLETED WELL: **52** ft. ELEVATION: _____
 Depth(s) Groundwater Encountered 1. _____ ft. 2. _____ ft. 3. _____ ft.
 WELL'S STATIC WATER LEVEL _____ ft. below land surface measured on mo/day/yr _____
 Pump test data: Well water was **NA** ft. after _____ hours pumping _____ gpm
 Est. Yield **NA** gpm: Well water was _____ ft. after _____ hours pumping _____ gpm
 Bore Hole Diameter **9.75** in. to **38.5** ft. and **5.75** in. to **53** ft.
 WELL WATER TO BE USED AS: 5 Public water supply 8 Air conditioning 11 Injection well
 1 Domestic 3 Feedlot 6 Oil field water supply 9 Dewatering 12 Other (Specify below)
 2 Irrigation 4 Industrial 7 Lawn and garden only **10** Monitoring well
 Was a chemical/bacteriological sample submitted to Department? Yes _____ No
 Water Well Disinfected? Yes _____ No

5 TYPE OF BLANK CASING USED: 5 Wrought iron 8 Concrete tile CASING JOINTS: Glued _____ Clamped _____
 1 Steel 3 RMP (SR) 6 Asbestos-Cement 9 Other (specify below) Welded _____
2 PVC 4 ABS 7 Fiberglass Threaded
 Blank casing diameter **6** in. to **38.5** ft. Dia. **2** in. to **42** ft. Dia. _____ in. to _____ ft.
 Casing height above land surface **2.49** in., weight _____ lbs./ft. Wall thickness or gauge No. **Sch. 40**
 TYPE OF SCREEN OR PERFORATION MATERIAL **7** PVC 10 Asbestos-cement
 1 Steel 3 Stainless steel 5 Fiberglass 8 RMP (SR) 11 Other (specify) _____
 2 Brass 4 Galvanized steel 6 Concrete tile 9 ABS 12 None used (open hole)
 SCREEN OR PERFORATION OPENINGS ARE: 5 Gauzed wrapped 8 Saw cut 11 None (open hole)
 1 Continuous slot **3** Mill slot 6 Wire wrapped 9 Drilled holes
 2 Louvered shutter 4 Key punched 7 Torch cut 10 Other (specify) _____
 SCREEN-PERFORATED INTERVALS: From **42** ft. to **52** ft. From _____ ft. to _____ ft.
 From _____ ft. to _____ ft. From _____ ft. to _____ ft.
 GRAVEL PACK INTERVALS: From **40** ft. to **53** ft. From _____ ft. to _____ ft.
 From _____ ft. to _____ ft. From _____ ft. to _____ ft.

6 GROUT MATERIAL: 1 Neat cement 2 Cement grout **3** Bentonite 4 Other _____
 Grout intervals: From **0.5** ft. to **40** ft. From _____ ft. to _____ ft. From _____ ft. to _____ ft.
 What is the nearest source of possible contamination:
 1 Septic tank 4 Lateral lines 7 Pit privy 10 Livestock pens 14 Abandoned water well
 2 Sewer lines 5 Cess pool 8 Sewage lagoon 11 Fuel storage 15 Oil well/Gas well
 3 Watertight sewer lines 6 Seepage pit 9 Feedyard 12 Fertilizer storage 16 Other (specify below)
 13 Insecticide storage _____
 Direction from well? _____ How many feet? _____

FROM	TO	LITHOLOGIC LOG	FROM	TO	PLUGGING INTERVALS
0	1.1	Clay, Brown with black mottling	83.8	85	Limestone, Gray
1.1	4.5	Limestone, Lt. Tan			
4.5	12.3	Limestone, Gray to Tan			
12.3	15.9	Shale, Tan			
15.9	24.4	Shale, Dark Gray			
24.4	30.6	Limestone, shaley,			
30.6	34	Limestone fragments,			
34	37	Shale, Blue Green			
37	42.5	Shale, Brick Red			
42.5	46.8	Shale, Lt. Tan			
46.8	51.2	Shale, Lt. Gray			
51.2	62.9	Limestone, dolomitic, Dark Gray			
62.9	78.2	Limestone, Dark Gray			SCIMW-14(D), Abovegrade
78.2	81.6	Limestone,			
81.6	83.8	Shale, Dark Gray			

7 CONTRACTOR'S OR LANDOWNER'S CERTIFICATION: This water well was **(1)** constructed, (2) reconstructed, or (3) plugged under my jurisdiction and was completed on (mo/day/year) **7/31/2009** and this record is true to the best of my knowledge and belief.
 Kansas Water Well Contractor's License No. **527** This Water Well Record was completed on (mo/day/yr) **8/28/2009**
 under the business name of **GeoCore, Inc.** by (signature) *Dale Bell*