


1 LOCATION OF WATER WELL: Fraction NW 1/4 SW 1/4 NW 1/4 Section Number 29 Township Number T 24 S Range Number R 4 **E/W**

Distance and direction from nearest town or city street address of well if located within city?
 ~300'E of Powell & ~300'S of Whitewater Ave.

2 WATER WELL OWNER: MRP Properties Company, LLC Lubrication Engineers, Inc.
 RR#, St. Address, Box # PO Box 696000 1919 East Tulsa
 City, State, ZIP Code San Antonio, TX 76269-6000 Wichita, KS 67216
 Board of Agriculture, Division of Water Resources
 Application Number:

3 LOCATE WELL'S LOCATION WITH AN "X" IN SECTION BOX:

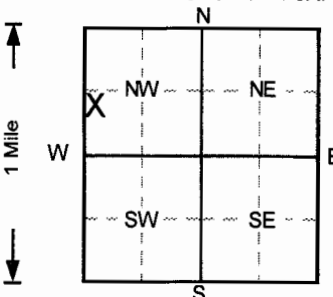

4 DEPTH OF COMPLETED WELL 29 ft ELEVATION:
 Depth(s) Groundwater Encountered 1. ft 2. ft 3. ft
 WELL'S STATIC WATER LEVEL ft below land surface measured on mo/day/yr
 Pump test data: Well water was NA ft after hours pumping gpm
 Est. Yield NA gpm: Well water was ft after hours pumping gpm
 Bore Hole Diameter 5.75 in. to 30 ft, and in. to ft
 WELL WATER TO BE USED AS: 5 Public water supply 8 Air conditioning 11 Injection well
 1 Domestic 3 Feedlot 6 Oil field water supply 9 Dewatering 12 Other (Specify below)
 2 Irrigation 4 Industrial 7 Lawn and garden only 10 Monitoring well
 Was a chemical/bacteriological sample submitted to Department? Yes.....No ; If yes, mo/day/yr sample was submitted Water Well Disinfected? Yes No

5 TYPE OF BLANK CASING USED: 1 Steel 2 PVC 3 RMP (SR) 4 ABS 5 Wrought iron 6 Asbestos-Cement 7 Fiberglass 8 Concrete tile 9 Other (specify below) CASING JOINTS: Glued Clamped Welded Threaded
 Blank casing diameter 2 in. to 19 ft, Dia. in. to ft, Dia. in. to ft
 Casing height above land surface 2.41 in., weight lbs./ft. Wall thickness or gauge No. Sch. 40
 TYPE OF SCREEN OR PERFORATION MATERIAL: 1 Steel 2 Brass 3 Stainless steel 4 Galvanized steel 5 Fiberglass 6 Concrete tile 7 PVC 8 RMP (SR) 9 ABS 10 Asbestos-cement 11 Other (specify) 12 None used (open hole)
 SCREEN OR PERFORATION OPENINGS ARE: 1 Continuous slot 2 Louvered shutter 3 Mill slot 4 Key punched 5 Gauzed wrapped 6 Wire wrapped 7 Torch cut 8 Saw cut 9 Drilled holes 10 Other (specify) 11 None (open hole)
 SCREEN-PERFORATED INTERVALS: From 19 ft to 29 ft, From ft to ft
 GRAVEL PACK INTERVALS: From 17 ft to 30 ft, From ft to ft

6 GROUT MATERIAL: 1 Neat cement 2 Cement grout 3 Bentonite 4 Other
 Grout intervals: From 0.5 ft to 17 ft, From ft to ft, From ft to ft
 What is the nearest source of possible contamination:
 1 Septic tank 2 Sewer lines 3 Watertight sewer lines 4 Lateral lines 5 Cess pool 6 Seepage pit 7 Pit privy 8 Sewage lagoon 9 Feedyard 10 Livestock pens 11 Fuel storage 12 Fertilizer storage 13 Insecticide storage 14 Abandoned water well 15 Oil well/Gas well 16 Other (specify below)
 Direction from well? How many feet?

FROM	TO	LITHOLOGIC LOG	FROM	TO	PLUGGING INTERVALS
0	3.5	Clay, Dark Brown			
3.5	5.6	Limestone fragments mixed w/clay,			
5.6	8.1	Limestone,			
8.1	12	Shale, Tan and Gray			
12	18.2	Shale, Dark Gray			
18.2	19.4	Shale, Tan and Gray			
19.4	21.4	Limestone, Gray			
21.4	22.5	Shale, Tan			
22.5	23.3	Limestone,			
23.3	28.8	Shale, Tan			
28.8	33.2	Shale, Green			
33.2	35	Shale, Brick Red			
					SCIMW-27(S) , Abovegrade

7 CONTRACTOR'S OR LANDOWNER'S CERTIFICATION: This water well was (1) constructed, (2) reconstructed, or (3) plugged under my jurisdiction and was completed on (mo/day/year) 7/28/2009 and this record is true to the best of my knowledge and belief.
 Kansas Water Well Contractor's License No. 527 This Water Well Record was completed on (mo/day/yr) 8/28/2009 under the business name of GeoCore, Inc. by (signature) Dan Koll