


1 LOCATION OF WATER WELL: Fraction NE 1/4 SW 1/4 SE 1/4 Section Number 4 Township Number T 24 S Range Number R 4 E
 County: Butler

Distance and direction from nearest town or city street address of well if located within city?
4 Mile North of Potwin

2 WATER WELL OWNER: Roland Ensz
 RR#, St. Address, Box #: R 1 Potwin 67123
 City, State, ZIP Code: Potwin 67123
 Board of Agriculture, Division of Water Resources
 Application Number:

3 LOCATE WELL'S LOCATION WITH AN "X" IN SECTION BOX:

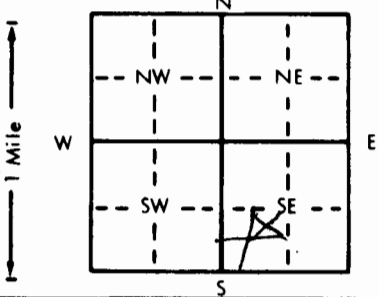

4 DEPTH OF COMPLETED WELL: 105 ft. ELEVATION:
 Depth(s) Groundwater Encountered 1. 75 ft. 2. ft. 3. ft.
 WELL'S STATIC WATER LEVEL 35 ft. below land surface measured on mo/day/yr
 Pump test data: Well water was 40 ft. after 1 hours pumping 50 gpm
 Est. Yield 50 gpm; Well water was ft. after hours pumping gpm
 Bore Hole Diameter: 8 1/2 in. to .ft., and .in. to .ft.

WELL WATER TO BE USED AS:
 1 Domestic 3 Feedlot 6 Oil field water supply 9 Dewatering 11 Injection well
 2 Irrigation 4 Industrial 7 Lawn and garden only 10 Observation well
 5 Public water supply 8 Air conditioning
 12 Other (Specify below)
 Was a chemical/bacteriological sample submitted to Department? Yes.....No.....; If yes, mo/day/yr sample was submitted
 Water Well Disinfected? Yes No

5 TYPE OF BLANK CASING USED:
 1 Steel 3 RMP (SR) 5 Wrought iron 8 Concrete tile CASING JOINTS: Glued Clamped
 2 PVC 4 ABS 6 Asbestos-Cement 9 Other (specify below) Welded
 7 Fiberglass Threaded

Blank casing diameter 5 in. to 100 ft., Dia. in. to .ft., Dia. in. to .ft.
 Casing height above land surface 18 in., weight 200 lbs./ft. Wall thickness or gauge No. 12 1/4

TYPE OF SCREEN OR PERFORATION MATERIAL:
 1 Steel 3 Stainless steel 5 Fiberglass 8 RMP (SR) 10 Asbestos-cement
 2 Brass 4 Galvanized steel 6 Concrete tile 9 ABS 11 Other (specify)
 12 None used (open hole)

SCREEN OR PERFORATION OPENINGS ARE:
 1 Continuous slot 3 Mill slot 5 Gauzed wrapped 8 Saw cut 11 None (open hole)
 2 Louvered shutter 4 Key punched 6 Wire wrapped 9 Drilled holes
 7 Torch cut 10 Other (specify)

SCREEN-PERFORATED INTERVALS: From 70 ft. to 90 ft., From .ft. to .ft.
 From .ft. to .ft., From .ft. to .ft.

GRAVEL PACK INTERVALS: From 13 ft. to 105 ft., From .ft. to .ft.
 From .ft. to .ft., From .ft. to .ft.

6 GROUT MATERIAL: 1 Neat cement 2 Cement grout 3 Bentonite 4 Other
 Grout Intervals: From 3 ft. to 13 ft., From .ft. to .ft., From .ft. to .ft.

What is the nearest source of possible contamination:
 1 Septic tank 4 Lateral lines 7 Pit privy 10 Livestock pens 14 Abandoned water well
 2 Sewer lines 5 Cess pool 8 Sewage lagoon 11 Fuel storage 15 Oil well/Gas well
 3 Watertight sewer lines 6 Seepage pit 9 Feedyard 12 Fertilizer storage 16 Other (specify below)
 13 Insecticide storage
 Direction from well? N
 How many feet? 100

FROM	TO	LITHOLOGIC LOG	FROM	TO	LITHOLOGIC LOG
0	3	Soil			
3	15	Clay			
15	25	Rock			
25	40	Clay			
40	55	Rock-Lime			
55	105	Lime			

7 CONTRACTOR'S OR LANDOWNER'S CERTIFICATION: This water well was (1) constructed, (2) reconstructed, or (3) plugged under my jurisdiction and was completed on (mo/day/year) 5/26/81 and this record is true to the best of my knowledge and belief. Kansas Water Well Contractor's License No. 251 This Water Well Record was completed on (mo/day/yr) 5/30/81 under the business name of Winter Well Drill by (signature) Charles Winter
 INSTRUCTIONS: Use typewriter or ball point pen, PLEASE PRESS FIRMLY and PRINT clearly. Please fill in blanks, underline or circle the correct answers. Send top three copies to Kansas Department of Health and Environment, Division of Environment, Environmental Geology Section, Topeka, KS 66620. Send one to WATER WELL OWNER and retain one for your records.