


1 LOCATION OF WATER WELL: County: Batter Fraction: NE 1/4 SE 1/4 NE 1/4 Section Number: 6 Township Number: T 24 S Range Number: R 4 E

Distance and direction from nearest town or city street address of well, if located within city?  
4 North 1 West of Potwin

2 WATER WELL OWNER: Ralph Clawson  
 RR#, St. Address, Box #: RR 1 White Water Kan Board of Agriculture, Division of Water Resources  
 City, State, ZIP Code: White Water Kan Application Number:

3 LOCATE WELL'S LOCATION WITH AN "X" IN SECTION BOX:

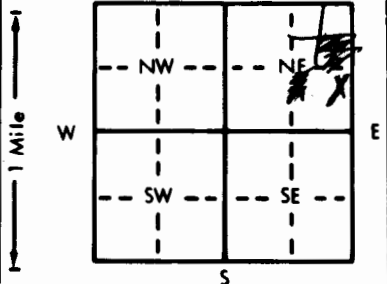

4 DEPTH OF COMPLETED WELL: 65 ft. ELEVATION:

Depth(s) Groundwater Encountered 1. 35 ft. 2. ft. 3. ft.  
 WELL'S STATIC WATER LEVEL 20 ft. below land surface measured on mo/day/yr  
 Pump test data: Well water was ft. after hours pumping gpm  
 Est. Yield 3.0 gpm; Well water was ft. after hours pumping gpm  
 Bore Hole Diameter: 8 1/2 in. to ft., and in. to ft.  
 WELL WATER TO BE USED AS:  
 1 Domestic     3 Feedlot     6 Oil field water supply     9 Dewatering     12 Other (Specify below)  
 2 Irrigation     4 Industrial     7 Lawn and garden only     10 Observation well  
 Was a chemical/bacteriological sample submitted to Department? Yes.....No.....; If yes, mo/day/yr sample was submitted  
 Water Well Disinfected? Yes  No

5 TYPE OF BLANK CASING USED:

1 Steel     3 RMP (SR)    5 Wrought iron    8 Concrete tile    CASING JOINTS: Glued  Clamped  
 2 PVC     4 ABS    6 Asbestos-Cement    9 Other (specify below)    Welded  
 7 Fiberglass    Threaded  
 Blank casing diameter 5 in. to 20 ft., Dia in. to ft., Dia in. to ft.  
 Casing height above land surface 18 in., weight 200 lbs./ft. Wall thickness or gauge No. 214

TYPE OF SCREEN OR PERFORATION MATERIAL:  
 1 Steel    3 Stainless steel    5 Fiberglass     7 PVC    10 Asbestos-cement  
 2 Brass    4 Galvanized steel    6 Concrete tile     8 RMP (SR)    11 Other (specify)  
 9 ABS    12 None used (open hole)

SCREEN OR PERFORATION OPENINGS ARE:  
 1 Continuous slot    3 Mill slot    5 Gauzed wrapped     8 Saw cut    11 None (open hole)  
 2 Louvered shutter    4 Key punched    6 Wire wrapped    9 Drilled holes  
 7 Torch cut    10 Other (specify)

SCREEN-PERFORATED INTERVALS: From 20 ft. to 65 ft., From ft. to ft.  
 From ft. to ft., From ft. to ft.  
 GRAVEL PACK INTERVALS: From ft. to ft., From ft. to ft.  
 From ft. to ft., From ft. to ft.

6 GROUT MATERIAL:  1 Neat cement     2 Cement grout    3 Bentonite    4 Other  
 Grout intervals: From 3 ft. to 13 ft., From ft. to ft., From ft. to ft.

What is the nearest source of possible contamination:  
 1 Septic tank    4 Lateral lines    7 Pit privy    10 Livestock pens    14 Abandoned water well  
 2 Sewer lines    5 Cess pool    8 Sewage lagoon    11 Fuel storage    15 Oil well/Gas well  
 3 Watertight sewer lines    6 Seepage pit    9 Feedyard    12 Fertilizer storage    16 Other (specify below)  
 13 Insecticide storage

Direction from well? S-W How many feet? 150

FROM	TO	LITHOLOGIC LOG	FROM	TO	LITHOLOGIC LOG
0	3	Soil			
3	10	clay			
10	20	rock			
20	40	sand & gravel			
40	65	shale			

7 CONTRACTOR'S OR LANDOWNER'S CERTIFICATION: This water well was  (1) constructed, (2) reconstructed, or (3) plugged under my jurisdiction and was completed on (mo/day/year) 1/14/86 and this record is true to the best of my knowledge and belief. Kansas Water Well Contractor's License No. 251 This Water Well Record was completed on (mo/day/yr) 2/2/86 under the business name of Winter Well Drill by (signature) Charles Winter