

TEST HOLE NUMBER 5B

Job Potwin Terminal, Kansas Location SE Tank 91

Date 2/20/86 Logged By C. Bartlett



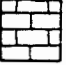









Drilling Company Jim Winnek, Inc. Driller Bob Maston Rig Air Rotary

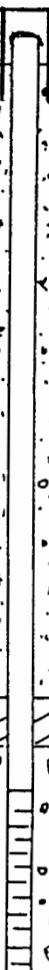
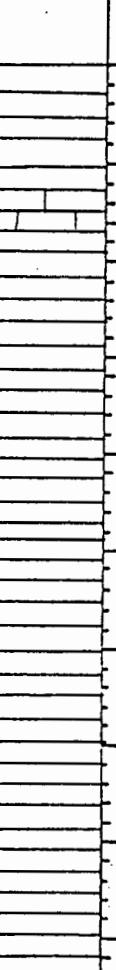
Hole Size 4-3/4" pilot, 7-7/8" Casing Details 4" threaded flush joint

PVC (Trilok) 10 ft 20 slot screen 40 ft blank

G. L. Elev. 1342.58 M. P. 2.6 Elev. M. P. 1345 18

LEGEND: 8-12 gravel pack

Topsoil		Sand		Limestone	
Clay		Bentonite		Native Fill	
Shale		Cement Grout		PVC Casing	
Silt		Gravel Pack		PVC Screen	

Casing	Log	Description	Remarks
		0 Shale, tan	
		5 Limestone, gray, white	
		10 Shale, brown, tan	
		15 Shale, green, brown	
		20 Shale, gray	
		25	
		30 Shale, green	
		35 Shale, red	
		40 Shale, green, water	