

TEST HOLE NUMBER 8B

Job Potwin Terminal, Kansas Location SE of Tank 58

Date 2/25/86 Logged By C. Bartlett









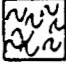


Drilling Company Jim Winnek, Inc. Driller Bob Masten Rig Air Rotary

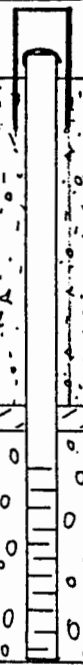
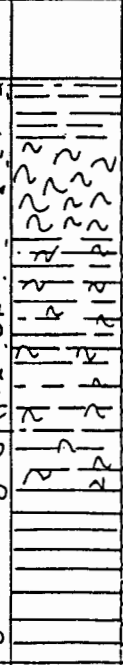
Hole Size 4-3/4" pilot, 7-7/8" Casing Details 4" threaded flush joint

PVC (Triloc) 20 ft 20 slot screen 25 ft blank

G. L. Elev. 1320.51 M. P. 2.2 Elev. M. P. 1322.71

LEGEND: 8-12 gravel pack

Topsoil		Sand			
Clay		Bentonite		Native Fill	
Shale		Cement Grout		PVC Casing	
Silt		Gravel Pack		PVC Screen	

Casing	Log	Description	Remarks
		0 Clay, brown	
		5 Silt, brown	
		10 Clay, silty, dark green and black	
		15	
		20 Clay, silty, green	
		Shale, red	
		25 Shale, green, water	
		30	
		35	
		40	