


1 LOCATION OF WATER WELL: Fraction Section Number Township Number Range Number
 County: Butler S2 1/4 SW 1/4 NW 1/4 29 T 24 S R 4 EW

Distance and direction from nearest town or city street address of well if located within city?

West of Potwin Kansas

2 WATER WELL OWNER: Lubrication Engineers Total Petroleum
 RR#, St. Address, Box #: P.O. Box 16447, 1919 E. Tulsa East Superior St. Board of Agriculture, Division of Water Resources
 City, State, ZIP Code: Wichita, KS Alma, Michigan 48802 Application Number:

3 LOCATE WELL'S LOCATION WITH AN "X" IN SECTION BOX: 4 DEPTH OF COMPLETED WELL: 100' ft. ELEVATION: 1332.38 (TOC)

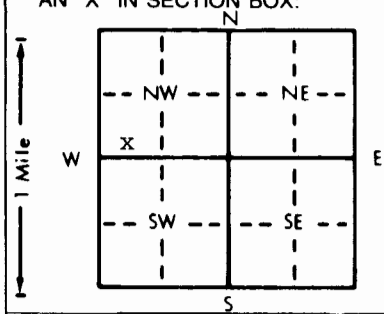

Depth(s) Groundwater Encountered 1. ft. 2. ft. 3. ft.
 WELL'S STATIC WATER LEVEL . . . 29.5 . . . ft. below land surface measured on mo/day/yr 4/24/90
 Pump test data: Well water was ft. after hours pumping gpm
 Est. Yield 30-50 gpm: Well water was ft. after hours pumping gpm
 Bore Hole Diameter in. to ft., and in. to ft.
 WELL WATER TO BE USED AS: 5 Public water supply 8 Air conditioning 11 Injection well
 1 Domestic 3 Feedlot 6 Oil field water supply 9 Dewatering 12 Other (Specify below)
 2 Irrigation 4 Industrial 7 Lawn and garden only 10 Monitoring well
 Was a chemical/bacteriological sample submitted to Department? Yes No; If yes, mo/day/yr sample was submitted
 Water Well Disinfected? Yes No

5 TYPE OF BLANK CASING USED: 5 Wrought iron 8 Concrete tile CASING JOINTS: Glued Clamped
 Steel 3 RMP (SR) 6 Asbestos-Cement 9 Other (specify below) Welded
 2 PVC 4 ABS 7 Fiberglass Threaded

Blank casing diameter . . . 12 . . . in. to . . . 19 . . . ft. Dia . . . in. to . . . ft. Dia . . . in. to . . . ft.
 Casing height above land surface 6" cut off to ~~xxxxxxx~~ 3' subsurface . . . lbs./ft. Wall thickness or gauge No.

TYPE OF SCREEN OR PERFORATION MATERIAL: 7 PVC 10 Asbestos-cement
 1 Steel 3 Stainless steel 5 Fiberglass 8 RMP (SR) 11 Other (specify)
 2 Brass 4 Galvanized steel 6 Concrete tile 9 ABS 12 None used (open hole)

SCREEN OR PERFORATION OPENINGS ARE: 5 Gauzed wrapped 8 Saw cut 11 None (open hole)
 1 Continuous slot 3 Mill slot 6 Wire wrapped 9 Drilled holes
 2 Louvered shutter 4 Key punched 7 Torch cut 10 Other (specify)

SCREEN-PERFORATED INTERVALS: From ft. to ft., From ft. to ft.
 From ft. to ft., From ft. to ft.
 GRAVEL PACK INTERVALS: From ft. to ft., From ft. to ft.
 From ft. to ft., From ft. to ft.

6 GROUT MATERIAL: 1 Neat cement Cement grout Bentonite 4 Other
 Grout Intervals: From . . . 100 . . . ft. to . . . 22 . . . ft. From . . . 22 . . . ft. to . . . 3 . . . ft., From ft. to ft.

What is the nearest source of possible contamination: 10 Livestock pens 14 Abandoned water well
 1 Septic tank 4 Lateral lines 7 Pit privy Fuel storage 15 Oil well/Gas well
 2 Sewer lines 5 Cess pool 8 Sewage lagoon 12 Fertilizer storage 16 Other (specify below)
 3 Watertight sewer lines 6 Seepage pit 9 Feedyard 13 Insecticide storage

Direction from well? North How many feet? 300'+

FROM	TO	LITHOLOGIC LOG	FROM	TO	PLUGGING INTERVALS
			100'	22	Bentonite
			22	3	Cement

7 CONTRACTOR'S OR LANDOWNER'S CERTIFICATION: This water well was (1) constructed, (2) reconstructed, or plugged under my jurisdiction and was completed on (mo/day/year) 4/24/90 and this record is true to the best of my knowledge and belief. Kansas Water Well Contractor's License No. 102 This Water Well Record was completed on (mo/day/yr) 4/18/90 under the business name of Layne Western Company, Inc. Wichita by (signature) Joe Schuman