


TEST HOLE NUMBER 98Job Potwin Terminal, Kansas Location N of Water Treatment PondsDate 2/26/86 Logged By C. BartlettDrilling Company Jim Winnek, Inc. Driller Bob Masten Rig Air RotaryHole Size 4-3/4" pilot, 7-7/8" Casing Details 4" threaded flush joint

PVC (Triloc) 10 ft 20 slot screen 46 ft blank

G. L. Elev. 1332.20 M. P. 2.3 Elev. M. P. 1334.50

LEGEND: 8-12 gravel pack

| | | | | | |
|---------|--|--------------|--|-------------|--|
| Topsoil | | Sand | | Limestone | |
| Clay | | Bentonite | | Native Fill | |
| Shale | | Cement Grout | | PVC Casing | |
| Silt | | Gravel Pack | | PVC Screen | |

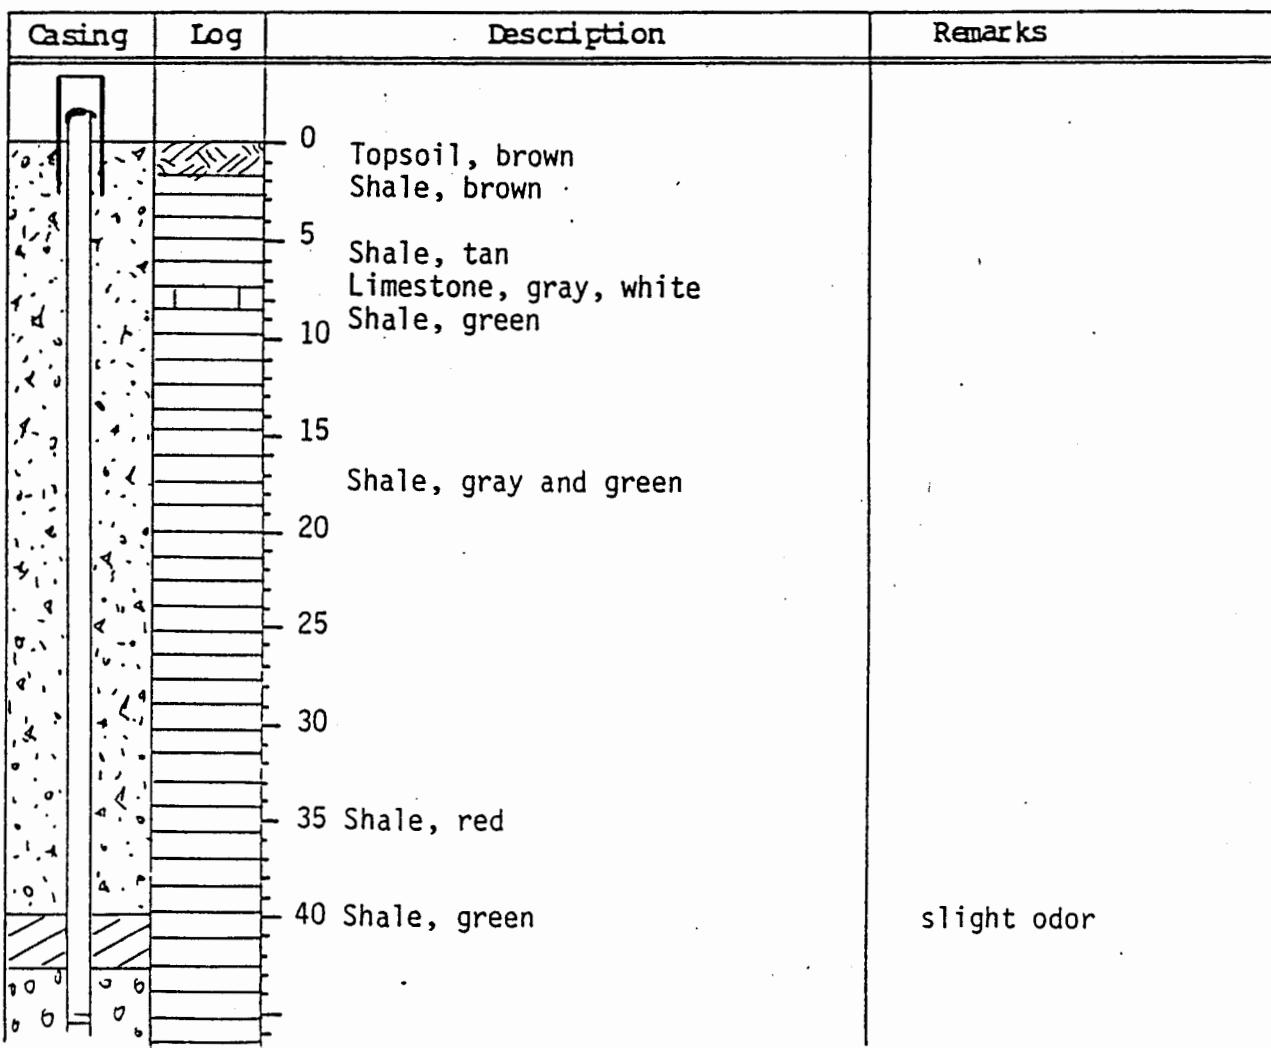

Test Hole Number 98