

WATER WELL RECORD Form WWC-5 KSA 82a-1212

1 LOCATION OF WATER WELL:	Fraction County: Butler	SW $\frac{1}{4}$	SW $\frac{1}{4}$	NE $\frac{1}{4}$	Section Number 30	Township Number T 24 S	Range Number R 4 E
---------------------------	----------------------------	------------------	------------------	------------------	----------------------	---------------------------	-----------------------

Distance and direction from nearest town or city street address of well if located within city?

1/4 south of Potwin, KS

2 WATER WELL OWNER: James E. Hinnen


RR#, St. Address, Box #: 3036 01e Court NE

Board of Agriculture, Division of Water Resources

City, State, ZIP Code: Albuquerque, NM 87111

Application Number:

3 LOCATE WELL'S LOCATION WITH AN "X" IN SECTION BOX:

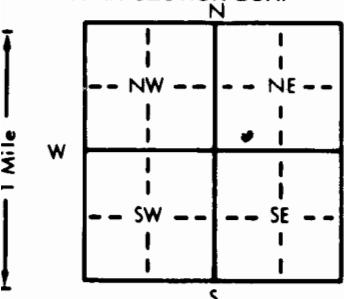

4 DEPTH OF COMPLETED WELL: 90 ft. ft. ELEVATION: 1314.98

Depth(s) Groundwater Encountered 1. 12.49 ft. 2. ft. 3. ft.

WELL'S STATIC WATER LEVEL 12.49 ft. below land surface measured on mo/day/yr 5/10/88

Pump test data: Well water was ft. after hours pumping gpm

Est. Yield gpm: Well water was ft. after hours pumping gpm

Bore Hole Diameter in. to ft. and in. to ft.

WELL WATER TO BE USED AS: 5 Public water supply 8 Air conditioning 11 Injection well

1 Domestic 3 Feedlot 6 Oil field water supply 9 Dewatering 12 Other (Specify below)

2 Irrigation 4 Industrial 7 Lawn and garden only 10 Observation well

Was a chemical/bacteriological sample submitted to Department? Yes. No. X. If yes, mo/day/yr sample was submitted

Water Well Disinfected? Yes No

5 TYPE OF BLANK CASING USED: 5 Wrought iron 8 Concrete tile CASING JOINTS: Glued Clamped

1 Steel 3 RMP (SR) 6 Asbestos-Cement 9 Other (specify below) Welded

2 PVC 4 ABS 7 Fiberglass Threaded

Blank casing diameter Plugged in. to ft. Dia in. to ft., Dia in. to ft.

Casing height above land surface in. weight lbs./ft. Wall thickness or gauge No.

TYPE OF SCREEN OR PERFORATION MATERIAL: 7 PVC 10 Asbestos-cement

1 Steel 3 Stainless steel 5 Fiberglass 8 RMP (SR) 11 Other (specify)

2 Brass 4 Galvanized steel 6 Concrete tile 9 ABS 12 None used (open hole)

SCREEN OR PERFORATION OPENINGS ARE: 5 Gauzed wrapped 8 Saw cut 11 None (open hole)

1 Continuous slot 3 Mill slot 6 Wire wrapped 9 Drilled holes

2 Louvered shutter 4 Key punched 7 Torch cut 10 Other (specify)

SCREEN-PERFORATED INTERVALS: From ft. to ft. From ft. to ft. From ft. to ft.

From ft. to ft. From ft. to ft. From ft. to ft.

GRAVEL PACK INTERVALS: From 34 ft. to 74 ft. From ft. to ft. From ft. to ft.

Native Fill From 74 ft. to 90 ft. From ft. to ft.

6 GROUT MATERIAL: 1 Neat cement 2 Cement grout 3 Bentonite 4 Other

Grout Intervals: From ft. to ft. From ft. to ft. From ft. to ft. From ft. to ft.

What is the nearest source of possible contamination:

1 Septic tank 4 Lateral lines 7 Pit privy 10 Livestock pens 14 Abandoned water well

2 Sewer lines 5 Cess pool 8 Sewage lagoon 11 Fuel storage 15 Oil well/Gas well

3 Watertight sewer lines 6 Seepage pit 9 Feedyard 12 Fertilizer storage 16 Other (specify below)

Direction from well? 3/4 east of well How many feet? 50 ft. *(in field)*

FROM TO LITHOLOGIC LOG FROM TO LITHOLOGIC LOG

0 2 Silt, dark to medium brown 55 61.5 Shale, dark gray to black

2 3 Limestone, dense, fine-med.grain tan 61.5 72 Limestone, med. gray w/occasional gray flint, fossiliferous, med.

3 10 Limey shale, tan to tan-gray w/ occasional scattered cobble-to-bouldered sized geodic nodules 72 77 Shale, dark gray

10 15 Shale, medium gray 77 83 Shale, dark gray w/interbedded med. gray very fine grained limestone

15 15.5 Shale, tan 83 87.5 Limestone, med. gray, very fine-grained w/interbedded dark gray shale

15.5 27 Shale, medium gray 87.5 90 Shale, dark gray with some occasional med. brown shale layers interbedded

25 27 Shale, pale brown-pink 90 95 w/some gray-brown to med. gray

27 40 Shale, brown-red 95 100 limestone

40 50 Shale, dark gray 100 105

47 48 Limestone, bit chatter 105 110

48 51 Shale, limey, hard, dark gray 110 115

51 55 Limestone, medium gray 115 120

7 CONTRACTOR'S OR LANDOWNER'S CERTIFICATION: This water well was (1) constructed, (2) reconstructed, or (3) plugged under my jurisdiction and was completed on (mo/day/year) 3-1-88 and this record is true to the best of my knowledge and belief. Kansas

Water Well Contractor's License No. WWC-L 334 This Water Well Record was completed on (mo/day/year) 8-31-88

under the business name of Eubank Inc. by (signature) *Indel Eubank*

INSTRUCTIONS: Use typewriter or ball point pen. PLEASE PRESS FIRMLY and PRINT clearly. Please fill in blanks, underline or circle the correct answers. Send top three copies to Kansas

Department of Health and Environment, Bureau of Water Protection, Topeka, Kansas 66620-7320, Telephone: 913-862-9360. Send one to WATER WELL OWNER and retain one for your records.