


1 LOCATION OF WATER WELL:	Fraction	Section Number	Township Number	Range Number
County: Butler	SE ¼ SE ¼ NE ¼	30	T 24 S	R 4 EW

Distance and direction from nearest town or city street address of well if located within city?

West of Potwin, KS

2	WATER WELL OWNER:	Lubrication Engineers	Total Petroleum
	RR#, St. Address, Box # :	P.O. Box 16447, 1919 E. Tulsa	East Superior St. Board of Agriculture, Division of Water Resources
	City, State, ZIP Code :	Wichita, KS	Alma, Michigan 48802 Application Number:

3	LOCATE WELL'S LOCATION WITH AN "X" IN SECTION BOX:	4	DEPTH OF COMPLETED WELL: 82	ft.	ELEVATION: 1335.75	(TOC)
---	--	---	-----------------------------	-----	--------------------	-------

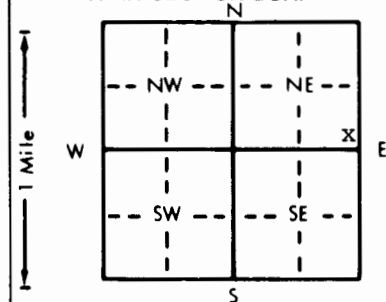

4 DEPTH OF COMPLETED WELL . . . 82 ft. ELEVATION: 1335.75 . . . (TOC)

Depth(s) Groundwater Encountered 1. ft. 2. ft. 3. ft.

WELL'S STATIC WATER LEVEL . . 36.46 . . . ft. below land surface measured on mo/day/yr 4/23/90

Pump test data: Well water was ft. after hours pumping gpm

Est. Yield gpm: Well water was ft. after hours pumping gpm

Bore Hole Diameter in. to ft., and in. to ft.

WELL WATER TO BE USED AS:

1 Domestic	3 Feedlot	6 Oil field water supply	9 Dewatering	11 Injection well
2 Irrigation	4 Industrial	7 Lawn and garden only	10 Monitoring well	12 Other (Specify below)

Was a chemical/bacteriological sample submitted to Department? Yes No; If yes, mo/day/yr sample was submitted

Water Well Disinfected? Yes No

5	TYPE OF BLANK CASING USED:		5 Wrought iron	8 Concrete tile	CASING JOINTS: Glued		Clamped
	1 Steel	3 RMP (SR)	6 Asbestos-Cement	9 Other (specify below)	Welded		
	2 PVC	4 ABS	7 Fiberglass	Cer-Mac Styrene SDR-26	Threaded		flush
	Blank casing diameter		6 in. to 11 ft. Dia	in. to ft. Dia		in. to ft.	
	Casing height above land surface		12 cut off to weight 3' subsurface	lbs./ft. Wall thickness or gauge No.			

TYPE OF SCREEN OR PERFORATION MATERIAL:				
1 Steel	3 Stainless steel	5 Fiberglass	7 PVC	10 Asbestos-cement
2 Brass	4 Galvanized steel	6 Concrete tile	8 RMP (SR)	11 Other (specify)
			9 ABS	12 None used (open hole)

SCREEN OR PERFORATION OPENINGS ARE:		5 Gauzed wrapped	8 Saw cut	11 None (open hole)
1 Continuous slot	3 Mill slot	6 Wire wrapped	9 Drilled holes	
2 Louvered shutter	4 Key punched	7 Torch cut	10 Other (specify)	

SCREEN-PERFORATED INTERVALS:	From ft. to ft.,	From ft. to ft.
	From ft. to ft.,	From ft. to ft.
GRAVEL PACK INTERVALS:	From ft. to ft.,	From ft. to ft.
	From ft. to ft.,	From ft. to ft.

6 GROUT MATERIAL: 1 Neat cement 2 Cement grout 3 Bentonite 4 Other
Grout Intervals: From 3 2 ft. to 20.8 2 ft. From 20.8 3 ft. to 82 3 ft. From . ft. to . ft.

What is the nearest source of possible contamination:			10 Livestock pens	14 Abandoned water well
1 Septic tank	4 Lateral lines	7 Pit privy	11 Fuel storage	15 Oil well/Gas well
2 Sewer lines	5 Cess pool	8 Sewage lagoon	12 Fertilizer storage	16 Other (specify below)
3 Watertight sewer lines	6 Seepage pit	9 Feedyard	13 Insecticide storage	

Direction from well?	East	How many feet?	500' +
----------------------	------	----------------	--------

[illegible]

7 CONTRACTOR'S OR LANDOWNER'S CERTIFICATION: This water well was (1) constructed, (2) reconstructed, or (3) plugged under my jurisdiction and was completed on (mo/day/year) 4/23/90 and this record is true to the best of my knowledge and belief. Kansas Water Well Contractor's License No. 102 This Water Well Record was completed on (mo/day/yr) 6/18/93 under the business name of Layne Western Company, Inc. Wichita by (signature) [Signature]