


WATER WELL PLUGGING RECORD Form WWC-5P KSA 82a-1212 ID NO.

(DRL KGS)

1 LOCATION OF WATER WELL: County: ~~Kingman~~ Butler Fraction NE 1/4 SE 1/4 NW 1/4 NW 1/4 Section Number 9 Township Number T 24 S Range Number 4 E W

Street/Rural Address of Well Location; if unknown, distance & direction from nearest town or intersection: If at owner's address, check here From intersection of NW River Rd. & NW 110 St., travel 1180ft. S. to unnamed road then 1160 ft. E to entrance Global Positioning Systems (GPS) information: Latitude: 37.9826 (in decimal degrees) Longitude: -97.0016 (in decimal degrees) Elevation: 1385.42 Horizontal Datum: WGS84, NAD83, NAD27 Collection Method: GPS unit (Make/Model: NA Digital Map/Photo, Topographic Map, Land Survey Est. Accuracy: < 3 m, 3-5 m, 5-15 m, > 15 m

2 WATER WELL OWNER: 22nd CES CEVQ USAF RR#, St. Address, Box #: 5300 Hutchinson St., Suite 109 City, State ZIP Code: Wichita, Ks. 67211

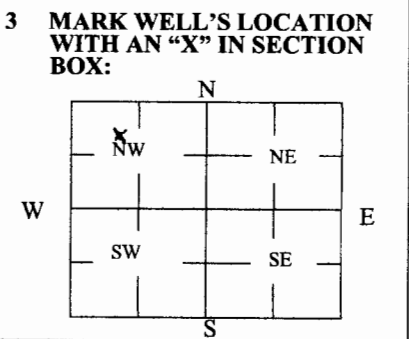

4 DEPTH OF WELL 58.85 ft. WELL'S STATIC WATER LEVEL 56.21 ft. WELL WAS USED AS: Domestic Public Water Supply Dewatering Irrigation Oil Field Water Supply Monitoring Feedlot Domestic (Lawn & Garden) Injection Well Industrial Air Conditioning Other Was a chemical/bacteriological sample submitted to Department? Yes No

5 TYPE OF BLANK CASING USED: Steel RMP (SR) Wrought Fiberglass Other (Specify below) PVC ABS Asbestos-Cement Concrete Tile Blank casing diameter 2 in. Was casing pulled? Yes No If yes, how much 3 ft. Casing height above or below land surface -36 in.

6 GROUT PLUG MATERIAL: Neat cement Cement grout Bentonite Other Grout Plug Intervals: From 0 ft. to 58.85 ft., From ft. to ft., From ft. to ft. What is the nearest source of possible contamination: Septic tank Seepage pit Fuel storage Other (specify below) Sewer lines Pit privy Fertilizer storage Watertight sewer lines Sewage lagoon Insecticide storage Lateral lines Feedyard Abandoned water well Direction from well? Cess pool Livestock pens Oil well/Gas well How many feet?

Table with columns: FROM, TO, PLUGGING MATERIALS. Row 1: 0, 58.85, Bentonite grout

7 CONTRACTOR'S OR LANDOWNER'S CERTIFICATION: This water well was plugged under my jurisdiction and was completed on (mo/day/year) 8/13/2018 and this record is true to the best of my knowledge and belief. Kansas Water Well Contractor's License No. 604. This Water Well Record was completed on (mo/day/year) 9/7/18 under the business name of Environmental Priority Service, Inc. by (signature) [Signature]

Send one white copy to Kansas Department of Health & Environment, Geology Section, 1000 SW Jackson Street, Ste. 420, Topeka, KS 66612-1367. Send one copy to WATER WELL OWNER and retain one for your records. Visit us at http://www.kdheks.gov/waterwell/index.html Telephone 785-296-5524.