


USE TYPEWRITER OR BALL POINT PEN-PRESS FIRMLY, PRINT CLEARLY.

WATER WELL RECORD
KSA 82a-1201-1215

Kansas Department of Health and Environment-Division of Environment
(Water well Contractors)
Topeka, Kansas 66620

1. Location of well: County Butler Fraction NE 1/4 NW 1/4 NW 1/4 Section number 14 Township number T 24 S Range number R 5 E

2. Distance and direction from nearest town or city: 9 N. on Hwy 77
Street address of well location if in city: El Dorado Kans
3. Owner of well: Eldon Locke
R.R. or street: Route 4
City, state, zip code: El Dorado Kans 67042

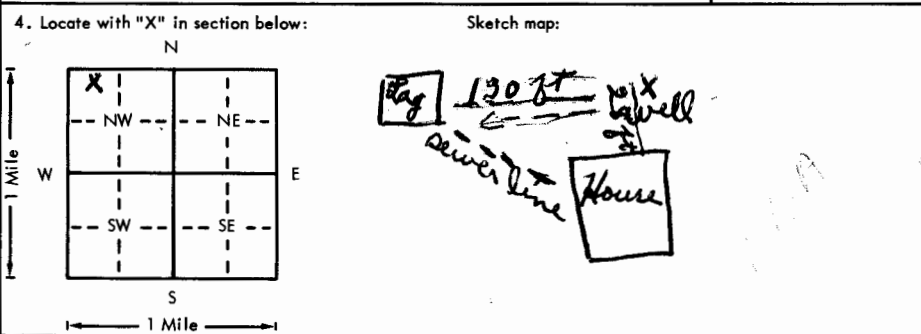

6. Bore hole dia. 10 in. Completion date 2-20-76
Well depth 120 ft.
7. Cable tool Rotary Driven Dug
 Hollow rod Jetted Bored Reverse rotary
8. Use: Domestic Public supply Industry
 Irrigation Air conditioning Stock
 Lawn Oil field water Other
9. Casing: Material plastic Height: Above or below
Threaded Welded Surface 20 in.
RMP PVC Weight lbs./ft.
Dia. 6 in. to 120 ft. depth Wall Thickness: inches or
Dia. in. to ft. depth gage No. 2175

5. Type and color of material	From	To
Brown Clay	0	18
yellow lime	18	30
Red Clay	30	35
Blue shale	35	45
Grey lime	45	55
yellow lime	55	68
Blue shale	68	75
grey lime	75	93
Red Clay	93	112
water	112	
grey lime	112	120

10. Screen: Manufacturer's name OK of Oklahoma City
Type RMP Dia. 6
Slot gauge 1/16 Length 20 ft
Set between 100 ft. and 120 ft.
 ft. and ft.
Gravel pack? No Size range of material
11. Static water level: 47 ft. below land surface Date 2-20-76 mo./day/yr.
12. Pumping level below land surfaces:
 ft. after hrs. pumping g.p.m.
 ft. after hrs. pumping g.p.m.
Estimated maximum yield 20 g.p.m.
13. Water sample submitted: mo./day/yr.
Yes No Date
14. Well head completion:
 Pitless adapter 20 inches above grade
15. Well grouted?
With: Neat cement Bentonite Concrete
Depth: From 0 ft. to 15 ft.
16. Nearest source of possible contamination: 130 ft. Direction West Type Lagoon
Well disinfected upon completion? Yes No
17. Pump: Not installed
Manufacturer's name
Model number HP Volts
Length of drop pipe ft. capacity g.p.m.
Type:
 Submersible Turbine
 Jet Reciprocating
 Centrifugal Other

18. Elevation:
19. Remarks:
owner will put on slab
Eldon L. Locke

20. Water well contractor's certification:
This well was drilled under my jurisdiction and this report is true to the best of my knowledge and belief.
Wike Well Drilling 122
Business name Wagonwheel License No.
Address El Dorado Kans
Signed Murray Wike Date 2-20-76
Authorized representative

24
50
4
1/4
1/4
1/4