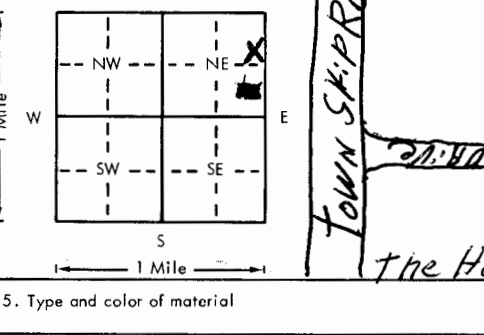


County BUTLER		Fraction SE 1/4 NE 1/4 NE 1/4	Section number 23	Township number T 24	Range number S R 5
1. Location of well: 8 mi. No. OF EL DORADO, ES.		3. Owner of well: ELDON LOCKE R.R. or street: R-4 City, state, zip code: EL DORADO, K 67042			
2. Distance and direction from nearest town or city: 8 mi. No. OF EL DORADO, ES.		4. Locate with "X" in section below: 			
5. Type and color of material		6. Bore hole dia. 8 in. Completion date 6-6-78 Well depth 98 ft.			
7. <input checked="" type="checkbox"/> Cable tool <input type="checkbox"/> Rotary <input type="checkbox"/> Driven <input type="checkbox"/> Dug <input type="checkbox"/> Hollow rod <input type="checkbox"/> Jetted <input type="checkbox"/> Bored <input type="checkbox"/> Reverse rotary		8. Use: <input checked="" type="checkbox"/> Domestic <input type="checkbox"/> Public supply <input type="checkbox"/> Industry <input type="checkbox"/> Irrigation <input type="checkbox"/> Air conditioning <input type="checkbox"/> Stock <input type="checkbox"/> Lawn <input type="checkbox"/> Oil field water <input type="checkbox"/> Other			
9. Casing: Material PVC Height: Above or below Threaded <input type="checkbox"/> Welded <input type="checkbox"/> Surface 17 in. RMP <input type="checkbox"/> PVC GL Weight <input type="checkbox"/> lbs./ft. Dia. 5 in. to 88 ft. depth Wall Thickness: inches or Dia. <input type="checkbox"/> in. to <input type="checkbox"/> ft. depth gage No. 1258		10. Screen: Manufacturer's name M. P. L. Type P.V.C Dia. 5 Slot/gauze 25/1000 Length 10 Set between 88 ft. and 98 ft. Gravel pack? yes Size range of material 5/16			
11. Static water level: 21 ft. below land surface Date 6-6-78		12. Pumping level below land surfaces: ____ ft. after ____ hrs. pumping ____ g.p.m. ____ ft. after ____ hrs. pumping ____ g.p.m. Estimated maximum yield 1.3 g.p.m.			
13. Water sample submitted: P.V.C. CAP mo./day/yr. <input type="checkbox"/> Yes <input checked="" type="checkbox"/> No Date		14. Well head completion: <input checked="" type="checkbox"/> Pitless adapter 17 inches above grade			
15. Well grouted? yes With: <input checked="" type="checkbox"/> Neat cement <input type="checkbox"/> Bentonite <input type="checkbox"/> Concrete Depth: From 3 ft. to 13 ft.		16. Nearest source of possible contamination: ft. 250 Direction NO. Type Lagoon Well disinfected upon completion? <input checked="" type="checkbox"/> Yes <input type="checkbox"/> No			
17. Pump: <input checked="" type="checkbox"/> Not installed Manufacturer's name Model number HP Volts Length of drop pipe ft. capacity g.p.m. Type: <input type="checkbox"/> Submersible <input type="checkbox"/> Turbine <input type="checkbox"/> Jet <input type="checkbox"/> Reciprocating <input type="checkbox"/> Centrifugal <input type="checkbox"/> Other		18. Water well contractor's certification: This well was drilled under my jurisdiction and this report is true to the best of my knowledge and belief. Prewitt Const. Co. 353 Business name Box 744 License No. Address Aurora, C. Prewitt Signed Aurora C. Prewitt Date 6-6-78 Authorized representative			
18. Elevation:		19. Remarks: OWNER WILL Pour his concrete slab. 4'x4'x4" * Eldon S. Locke			
Topography: <input type="checkbox"/> Hill <input type="checkbox"/> Slope <input checked="" type="checkbox"/> Upland <input type="checkbox"/> Valley					