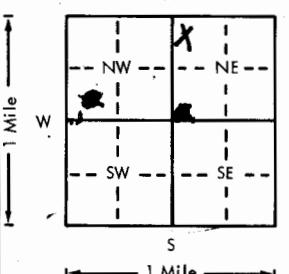
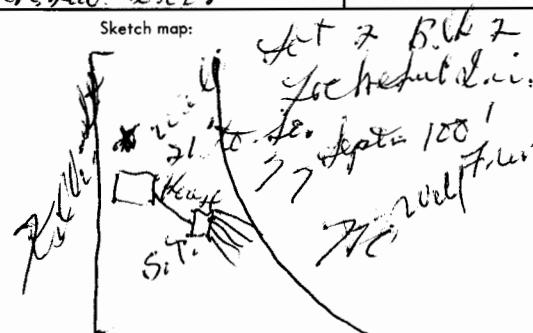


USE TYPEWRITER OR BALL
POINT PEN-PRESS FIRMLY,
PRINT CLEARLY.

WATER WELL RECORD
KSA 82a-1201-1215

41

Kansas Department of Health and
Environment-Division of Environment
(Water well Contractors)
Topeka, Kansas 66620

1. Location of well:	County <u>Butler</u>	Fraction <u>NW 1/4 NW 1/4 NE 1/4</u>	Section number <u>23</u>	Township number <u>T 24</u>	Range number <u>S R 5</u>
2. Distance and direction from nearest town or city:	<u>El Dorado</u>		3. Owner of well:	<u>El Dorado</u> <u>Locke</u>	
Street address of well location if in city:	<u>Lot in 13th & Locke Sub. Lino.</u>		R.R. or street:	<u>El Dorado</u> <u>Mo.</u>	
4. Locate with "X" in section below:			Sketch map:		
5. Type and color of material	From	To	<u>6. Bore hole dia. 6 in. Completion date 9-18-77</u> <u>Well depth 100 ft.</u>		
<u>Topsoil</u>	<u>0</u>	<u>3</u>	<u>7. Cable tool <input checked="" type="checkbox"/> Rotary <input type="checkbox"/> Driven <input type="checkbox"/> Dug</u> <u><input type="checkbox"/> Hollow rod <input checked="" type="checkbox"/> Jetted <input type="checkbox"/> Bored <input type="checkbox"/> Reverse rotary</u>		
<u>Red clay</u>	<u>3</u>	<u>18</u>	<u>8. Use: <input checked="" type="checkbox"/> Domestic <input type="checkbox"/> Public supply <input type="checkbox"/> Industry</u> <u><input type="checkbox"/> Irrigation <input type="checkbox"/> Air conditioning <input type="checkbox"/> Stock</u> <u><input type="checkbox"/> Lawn <input type="checkbox"/> Oil field water <input type="checkbox"/> Other</u>		
<u>Limestone</u>	<u>18</u>	<u>43</u>	<u>9. Casing: Material <input type="checkbox"/> PVC <input checked="" type="checkbox"/> Steel <input type="checkbox"/> Other</u> <u>Height: Above or below</u> <u>Threaded <input type="checkbox"/> Welded <input checked="" type="checkbox"/> Surface 30 in.</u> <u>RMP <input type="checkbox"/> PVC <input checked="" type="checkbox"/> Weight lbs./ft.</u> <u>Dia. 5 in. to 6 ft. depth, Wall thickness inches or</u> <u>Dia. in. to ft. depth gage No. 1000</u>		
<u>Gray shale</u>	<u>43</u>	<u>66</u>	<u>10. Screen: Manufacturer's name M.P.L.</u> <u>Type <input type="checkbox"/> PVC <input checked="" type="checkbox"/> Steel <input type="checkbox"/> Other</u> <u>Dia. 5 in. <input type="checkbox"/> N.C. <input checked="" type="checkbox"/> M.N.C.</u> <u>Slot/gauze 25/100 <input type="checkbox"/> Length 10 ft.</u> <u>Set between <input type="checkbox"/> ft. and 56-66 ft.</u> <u><input type="checkbox"/> ft. and 66-73 ft.</u> <u>Gravel pack? <input type="checkbox"/> Size range of material 570</u>		
			<u>11. Static water level: 18 ft. below land surface Date 9-18-77</u> <u>mo./day/yr.</u>		
			<u>12. Pumping level below land surfaces:</u> <u>ft. after hrs. pumping g.p.m.</u> <u>ft. after hrs. pumping g.p.m.</u> <u>Estimated maximum yield 21 g.p.m.</u>		
			<u>13. Water sample submitted: mo./day/yr.</u> <u>Yes <input checked="" type="checkbox"/> No <input type="checkbox"/> Date</u>		
			<u>14. Well head completion:</u> <u>Pitless adapter inches above grade</u>		
			<u>15. Well grouted?</u> <u>With: <input checked="" type="checkbox"/> Neat cement <input type="checkbox"/> Bentonite <input type="checkbox"/> Concrete</u> <u>Depth: From 0 ft. to 0 ft.</u>		
			<u>16. Nearest source of possible contamination: 70 ft. 100 ft. Type <input type="checkbox"/> Lignite</u> <u>Well disinfected upon completion? <input checked="" type="checkbox"/> Yes <input type="checkbox"/> No</u>		
			<u>17. Pump: Not installed</u> <u>Manufacturer's name</u> <u>Model number HP Volts</u> <u>Length of drop pipe ft. capacity g.p.m.</u> <u>Type:</u> <u><input type="checkbox"/> Submersible <input type="checkbox"/> Turbine</u> <u><input type="checkbox"/> Jet <input type="checkbox"/> Reciprocating</u> <u><input type="checkbox"/> Centrifugal <input type="checkbox"/> Other</u>		
18. Elevation:	(Use a second sheet if needed)		<u>20. Water well contractor's certification:</u> <u>This well was drilled under my jurisdiction and this report is true to the best of my knowledge and belief.</u> <u>Platt, Com. Co.</u> <u>Business name</u> <u>Address Box 243 S.S. 3</u> <u>Signed <input type="checkbox"/> Authorized representative</u> <u>Date 9-18-77</u>		
Topography:	<input type="checkbox"/> Hill <input type="checkbox"/> Slope <input checked="" type="checkbox"/> Upland <input type="checkbox"/> Valley				
19. Remarks:					