

Sent 7-18-77


USE TYPEWRITER OR BALL POINT PEN-PRESS FIRMLY, PRINT CLEARLY.

WATER WELL RECORD  
KSA 82a-1201-1215

Kansas Department of Health and Environment-Division of Environment  
(Water well Contractors)  
Topeka, Kansas 66620

LOT 7-Block I

1. Location of well: <b>BUTLER</b>		County <b>BUTLER</b>	Fraction <b>NE 1/4 NW 1/4 NE 1/4</b>	Section number <b>23</b>	Township number <b>T 24 S R 5</b>	Range number <b>EW</b>
2. Distance and direction from nearest town or city: <b>8 1/2 mil North of ELDONADO, KAN on Hwy 77</b>		3. Owner of well: <b>CHARLES CHAMBERLIN</b>		R.R. or street: <b>R # 1</b>		
Street address of well location if in city: <b>THE EAST 1/4 MI</b>		City, state, zip code: <b>ELDONADO, KAN. 67042</b>				
4. Locate with "X" in section below:		Sketch map: <b>TW R.D</b>		6. Bore hole dia. <b>9 1/2</b> in. Completion date <b>6-10-77</b> Well depth <b>108</b> ft.		
				7. Cable tool <input type="checkbox"/> Rotary <input type="checkbox"/> Driven <input type="checkbox"/> Dug <input type="checkbox"/> <input type="checkbox"/> Hollow rod <input type="checkbox"/> Jetted <input type="checkbox"/> Bored <input type="checkbox"/> Reverse rotary		
5. Type and color of material		From	To	8. Use: <input checked="" type="checkbox"/> Domestic <input type="checkbox"/> Public supply <input type="checkbox"/> Industry <input type="checkbox"/> Irrigation <input type="checkbox"/> Air conditioning <input type="checkbox"/> Stock <input type="checkbox"/> Lawn <input type="checkbox"/> Oil field water <input type="checkbox"/> Other		
<b>0-2 Topsoil</b>				9. Casing: Material <b>Plastic</b> Height: <b>Above</b> or below Threaded <input type="checkbox"/> Welded <input type="checkbox"/> Surface <b>24</b> in. RMP <input type="checkbox"/> PVC <input checked="" type="checkbox"/> Weight _____ lbs./ft. Dia. <b>5</b> in. to <b>108</b> ft. depth Wall Thickness: inches of Dia. <b>5</b> in. to <b>108</b> ft. depth Gauge No. <b>PUC 120 SPR 21</b>		
<b>2-12 Redish Clay</b>				10. Screens: Manufacturer's name <b>ASTM - 190 PSI</b> Type <b>5CH #40</b> Dia. <b>5"</b> Slot/gauze <b>46</b> Length <b>10'</b> Set between <b>98</b> ft. and <b>108</b> ft. ft. and _____ ft. Gravel pack? <input checked="" type="checkbox"/> Size range of material <b>1/8-1/4</b>		
<b>12-34 Red &amp; Grayish Clay</b>				11. Static water level: _____ mo./day/yr. <b>20</b> ft. below land surface Date <b>6-10-77</b>		
<b>34-44 gray shale</b>				12. Pumping level below land surfaces: ft. after _____ hrs. pumping ft. after _____ hrs. pumping <b>COULD NOT PUMP</b> Estimated maximum yield _____ g.p.m.		
<b>44-63 Lime</b>				13. Water sample submitted: _____ mo./day/yr. Yes <input type="checkbox"/> No <input checked="" type="checkbox"/> Date _____		
<b>63-64 GRAVEL - V to C.</b>				14. Well head completion: <input checked="" type="checkbox"/> Pitless adapter <b>24</b> Inches above grade		
<b>64-77 Blue shale</b>				15. Well grouted? <b>yes</b> With: <input checked="" type="checkbox"/> Neat cement <input type="checkbox"/> Bentonite <input type="checkbox"/> Concrete Depth: From <b>3</b> ft. to <b>13</b> ft. <b>MNC</b>		
<b>77-85 Grayish shale</b>				16. Nearest source of possible contamination: ft. <b>2500</b> Direction <b>WEST</b> Type <b>River</b> Well disinfected upon completion? <input checked="" type="checkbox"/> Yes <input type="checkbox"/> No		
<b>85-96 Redish Clay</b>				17. Pump: <input checked="" type="checkbox"/> Not installed Manufacturer's name _____ Model number _____ HP _____ Volts _____ Length of drop pipe _____ ft. capacity _____ g.p.m. Type: <input type="checkbox"/> Submersible <input type="checkbox"/> Turbine <input type="checkbox"/> Jet <input type="checkbox"/> Reciprocating <input type="checkbox"/> Centrifugal <input type="checkbox"/> Other		
<b>96-108 Lime</b>				20. Water well contractor's certification: This well was drilled under my jurisdiction and this report is true to the best of my knowledge and belief. <b>BJS Well Drilling</b> Business name _____ License No. _____ Address <b>R # 1 ELDONADO 335A</b> Signed <b>Bart Noyes</b> Date <b>6-29-77</b> Authorized representative		
18. Elevation:		19. Remarks:				
Topography: <input type="checkbox"/> Hill <input checked="" type="checkbox"/> Slope <input type="checkbox"/> Upland <input type="checkbox"/> Valley						

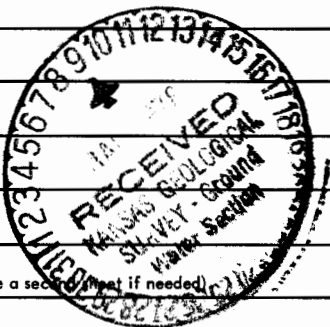

160 PSI  
-214" MNC

24  
-50  
23  
NE NW NE  
1/4 1/4 1/4