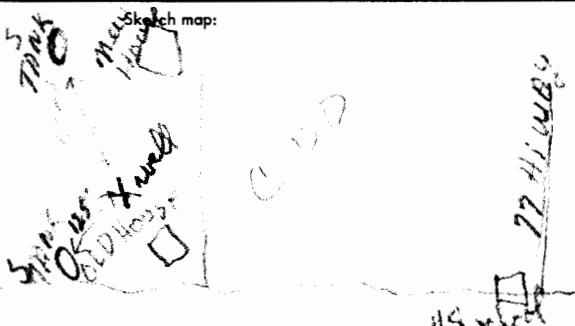


USE TYPEWRITER OR BALL
POINT PEN-PRESS FIRMLY,
PRINT CLEARLY.

WATER WELL RECORD
KSA 82a-1201-1215

Kansas Department of Health and
Environment-Division of Environment
(Water well Contractors)
Topeka, Kansas 66620

1. Location of well:	County Butler	Fraction SE 1/4 SE 1/4 SW 1/4	Section number 34	Township number T 26	Range number S R 5 E 000
2. Distance and direction from nearest town or city:	010 #8 School Chastillion		3. Owner of well: R.R. or street: Galen MEATS R#4	Completion date 10-5-76	
Street address of well location if in city:	1/2 mile east & 1/2 mile N. on Hwy 160		State, zip code: KANSAS	Well depth 100 ft.	
4. Locate with "X" in section below:			Sketch map:	6. Bore hole dia. 8 in. Completion date Well depth 100 ft. Date 10-5-76	
	N	E		7. <input checked="" type="checkbox"/> Cable tool <input type="checkbox"/> Rotary <input type="checkbox"/> Driven <input type="checkbox"/> Dug <input type="checkbox"/> Hollow rod <input type="checkbox"/> Jetted <input type="checkbox"/> Bored <input type="checkbox"/> Reverse rotary	
	W	S		8. Use: <input checked="" type="checkbox"/> Domestic <input type="checkbox"/> Public supply <input type="checkbox"/> Industry <input type="checkbox"/> Irrigation <input type="checkbox"/> Air conditioning <input type="checkbox"/> Stock <input type="checkbox"/> Lawn <input type="checkbox"/> Oil field water <input type="checkbox"/> Other	
	1 Mile			9. Casing: Material PVC Height: Above or below Threaded <input type="checkbox"/> Welded <input type="checkbox"/> Surface 18 in. RMP 100 ft. 18 lbs./ft. Dia. 5 in. to 100 ft. depth Wall thickness: inches or Dia. 5 in. to 100 ft. depth Gauge No. SC440	
5. Type and color of material			From 0	To 5	10. Screen: Manufacturer's name NSF Type PVC Dia. 5 Slot/gauze 1/16 Length 50 Set between 50 ft. and 100 ft. ft. and 100 ft. Gravel pack? <input checked="" type="checkbox"/> Size range of material 1/4 - 1/8
			5	30	11. Static water level: 70 ft. below land surface Date 10-5-76
			30	62	12. Pumping level below land surfaces: could not be located ft. after 0 hrs. pumping 0 g.p.m. ft. after 0 hrs. pumping 0 g.p.m.
			62	90	Estimated maximum yield 0 g.p.m.
			90	93	13. Water sample submitted: 0 mo./day/yr. Yes <input checked="" type="checkbox"/> No <input type="checkbox"/> Date 10-5-76
			93	100	14. Well head completion: Pitless adapter 0 inches above grade
					15. Well grouted? yes With: <input checked="" type="checkbox"/> Neat cement <input type="checkbox"/> Bentonite <input type="checkbox"/> Concrete Depth: From 0 ft. to 11 ft.
					16. Nearest source of possible contamination: Septic ft. 125 Direction N+E Type Tank Well disinfected upon completion? <input checked="" type="checkbox"/> Yes <input type="checkbox"/> No
					17. Pump: <input checked="" type="checkbox"/> Not installed Manufacturer's name 0 Model number 0 HP 0 Volts 0 Length of drop pipe 0 ft. capacity 0 g.p.m. Type: <input type="checkbox"/> Submersible <input type="checkbox"/> Turbine <input type="checkbox"/> Jet <input type="checkbox"/> Reciprocating <input type="checkbox"/> Centrifugal <input type="checkbox"/> Other
(Use a second sheet if needed)					18. Elevation: Topography: <input type="checkbox"/> Hill <input checked="" type="checkbox"/> Slope <input type="checkbox"/> Upland <input type="checkbox"/> Valley
19. Remarks:			20. Water well contractor's certification: This well was drilled under my jurisdiction and this report is true to the best of my knowledge and belief. BARTHOGOBOOM DRILL 335 Business name 0 License No. 0 Address 1441 El Dorado Ave Signed Bart J. Goboom Date 6-6-76 Authorized representative		