


1 LOCATION OF WATER WELL: Fraction NE 1/4 NW 1/4 NE 1/4 Section Number 29 Township Number T 24 S Range Number R 6 E/W  
 County: Batler

Distance and direction from nearest town or city street address of well if located within city?  
6 North & 4 East of Eldorado KS

2 WATER WELL OWNER: JEFF Canady Eldorado KS  
 RR#, St. Address, Box #: 113 E Locust 67042 Board of Agriculture, Division of Water Resources  
 City, State, ZIP Code: 113 E Locust 67042 Application Number:

3 LOCATE WELL'S LOCATION WITH AN "X" IN SECTION BOX: 4 DEPTH OF COMPLETED WELL 147 ft. ELEVATION:  
 Depth(s) Groundwater Encountered 1.120 ft. 2. .ft. 3. .ft.  
 WELL'S STATIC WATER LEVEL 35 ft. below land surface measured on mo/day/yr

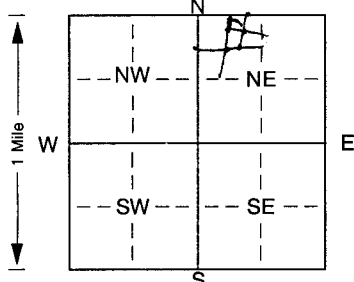

Pump test data: Well water was .ft. after .hours pumping .gpm  
 Est. Yield 15 gpm; Well water was .ft. after .hours pumping .gpm  
 Bore Hole Diameter 9 1/2 in. to .ft., and .in. to .ft.  
 WELL WATER TO BE USED AS: 5 Public water supply 8 Air conditioning 11 Injection well  
 1 Domestic 3 Feedlot 6 Oil field water supply 9 Dewatering 12 Other (Specify below)  
 2 Irrigation 4 Industrial 7 Domestic (lawn & garden) 10 Monitoring well  
 Was a chemical/bacteriological sample submitted to Department? Yes. . No.  ; If yes, mo/day/yr sample was submitted  
 Water Well Disinfected? Yes  No

5 TYPE OF BLANK CASING USED: 5 Wrought iron 8 Concrete tile CASING JOINTS: Glued.  Clamped. .  
 1 Steel 3 RMP (SR) 6 Asbestos-Cement 9 Other (specify below) Welded .  
 2 PVC 4 ABS 7 Fiberglass Threaded .

Blank casing diameter 3 in. to 80 ft., Dia 18 in. to .ft., Dia .in. to .ft.  
 Casing height above land surface 18 in., weight 160 lbs./ft. Wall thickness or gauge No. 12.14

TYPE OF SCREEN OR PERFORATION MATERIAL:  PVC 10 Asbestos-cement  
 1 Steel 3 Stainless steel 5 Fiberglass 8 RMP (SR) 11 Other (specify) .  
 2 Brass 4 Galvanized steel 6 Concrete tile 9 ABS 12 None used (open hole)

SCREEN OR PERFORATION OPENINGS ARE: 5 Gauzed wrapped  8 Saw cut 11 None (open hole)  
 1 Continuous slot 3 Mill slot 6 Wire wrapped 9 Drilled holes  
 2 Louvered shutter 4 Key punched 7 Torch cut 10 Other (specify) .ft.

SCREEN-PERFORATED INTERVALS: From 80 ft. to 147 ft., From .ft. to .ft.  
 From .ft. to .ft., From .ft. to .ft.  
 GRAVEL PACK INTERVALS: From .ft. to .ft., From .ft. to .ft.  
 From .ft. to .ft., From .ft. to .ft.

6 GROUT MATERIAL: 1 Neat cement 2 Cement grout  3 Bentonite 4 Other .  
 Grout Intervals: From 3 ft. to 23 ft., From 0 ft. to .ft., From .ft. to .ft.

What is the nearest source of possible contamination:  
 1 Septic tank 4 Lateral lines 7 Pit privy 10 Livestock pens 14 Abandoned water well  
 2 Sewer lines 5 Cess pool  8 Sewage lagoon 11 Fuel storage 15 Oil well/Gas well  
 3 Watertight sewer lines 6 Seepage pit 9 Feedyard 12 Fertilizer storage 16 Other (specify below)  
 13 Insecticide storage

Direction from well? SE How many feet? 250

FROM	TO	LITHOLOGIC LOG	FROM	TO	PLUGGING INTERVALS
<u>0</u>	<u>4</u>	<u>SOIL</u>			
<u>4</u>	<u>18</u>	<u>CLAY</u>			
<u>18</u>	<u>147</u>	<u>SAND &amp; LIME</u>			

7 CONTRACTOR'S OR LANDOWNER'S CERTIFICATION: This water well was  (1) constructed, (2) reconstructed, or (3) plugged under my jurisdiction and was completed on (mo/day/year) 9/3/02 and this record is true to the best of my knowledge and belief. Kansas Water Well Contractor's Licence No. 2519 This Water Well Record was completed on (mo/day/yr) 10/31/03 under the business name of Winterwell Drill by signature Charles Winter