

1 LOCATION OF WATER WELL:

Fraction

Section Number

Township Number

Range Number

County: BentonNE $\frac{1}{4}$ SE $\frac{1}{4}$ SE $\frac{1}{4}$

1

T 24

S

R 6

EW

Distance and direction from nearest town or city street address of well if located within city?

4.5 miles S of Burns, Kan 8-E-1-N

2 WATER WELL OWNER:

Stewart Bair

RR#, St. Address, Box #:

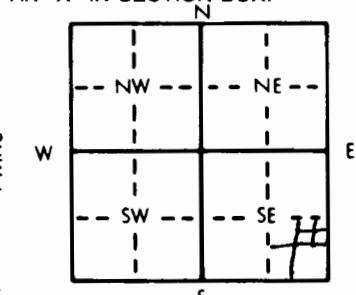
Eldorado, Kan 66842

Board of Agriculture, Division of Water Resources

City, State, ZIP Code

Application Number:

3 LOCATE WELL'S LOCATION WITH AN "X" IN SECTION BOX:

4 DEPTH OF COMPLETED WELL: 100 ft. ELEVATION:Depth(s) Groundwater Encountered 1. 85 ft. 2. ft. 3. ft.WELL'S STATIC WATER LEVEL 50 ft. below land surface measured on mo/day/yr

Pump test data: Well water was ft. after hours pumping gpm

Est. Yield 60 gpm Well water was ft. after hours pumping gpmBore Hole Diameter 8 1/2 in. to ft., and in. to ft.

WELL WATER TO BE USED AS: 5 Public water supply 8 Air conditioning 11 Injection well

1 Domestic 3 Feedlot 6 Oil field water supply 9 Dewatering 12 Other (Specify below)

2 Irrigation 4 Industrial 7 Lawn and garden only 10 Monitoring well

Was a chemical/bacteriological sample submitted to Department? Yes No If yes, mo/day/yr sample was submitted

Water Well Disinfected? Yes No

5 TYPE OF BLANK CASING USED:

1 Steel 3 RMP (SR)
2 PVC 4 ABS

5 Wrought iron 8 Concrete tile Casing joints: Glued Clamped

6 Asbestos-Cement 9 Other (specify below) Welded

7 Fiberglass Threaded

Blank casing diameter

5 in. to 70 ft. Dia in. to ft. Dia in. to ft.Casing height above land surface 18 in., weight 200 lbs./ft. Wall thickness or gauge No. 214

TYPE OF SCREEN OR PERFORATION MATERIAL:

1 Steel 3 Stainless steel
2 Brass 4 Galvanized steel

7 PVC 10 Asbestos-cement

8 RMP (SR) 11 Other (specify)

9 ABS 12 None used (open hole)

SCREEN OR PERFORATION OPENINGS ARE:

1 Continuous slot 3 Mill slot
2 Louvered shutter 4 Key punched

5 Gauzed wrapped 8 Saw cut 11 None (open hole)

6 Wire wrapped 9 Drilled holes

7 Torch cut 10 Other (specify)

SCREEN-PERFORATED INTERVALS:

From. 70 ft. to 160 ft. From ft. to ft. From ft. to ft.

From. ft. to ft. From ft. to ft. From ft. to ft.

GRAVEL PACK INTERVALS:

From. ft. to ft. From ft. to ft. From ft. to ft.

From ft. to ft. From ft. to ft. From ft. to ft.

6 GROUT MATERIAL:

1 Neat cement 2 Cement grout 3 Bentonite 4 OtherGrout Intervals: From. 0 ft. to 20 ft., From ft. to ft., From ft. to ft.

What is the nearest source of possible contamination: 10 Livestock pens 14 Abandoned water well

1 Septic tank 4 Lateral lines 7 Pit privy 11 Fuel storage 15 Oil well/Gas well
2 Sewer lines 5 Cess pool 8 Sewage lagoon 12 Fertilizer storage 16 Other (specify below)
3 Watertight sewer lines 6 Seepage pit 9 Feedyard 13 Insecticide storage

Direction from well?

5

How many feet?

500

7 LITHOLOGIC LOG

FROM TO

0 5 Soil

5 10 Rock

10 22 Clay

22 160 Shale & Clay

PLUGGING INTERVALS

7 CONTRACTOR'S OR LANDOWNER'S CERTIFICATION: This water well was constructed, (2) reconstructed, or (3) plugged under my jurisdiction and was completed on (mo/day/year) 6/5/89 and this record is true to the best of my knowledge and belief. KansasWater Well Contractor's License No. 257 This Water Well Record was completed on (mo/day/yr) 6/2/89under the business name of Winter Well Drill by (signature) Charles Winter