

1. LOCATION OF WATER WELL

County: Butler

Fraction

1/4 SE

1/4

Section Number

Township Number

T 24 S

Range Number

R 6 E/WDistance and direction from nearest town or city? 10 miles North
AND 4 miles East 1/2 N of El Dorado

Street address of well if located within city?

2. WATER WELL OWNER:

Eruin C GrantRR#, St. Address, Box # 525 Harvard

Board of Agriculture, Division of Water Resources

City, State, ZIP Code El Dorado, Kansas

Application Number:

3. DEPTH OF COMPLETED WELL

120 ft. Bore Hole Diameter 8 1/8 in. to 120 ft., and in. to ft.

Well Water to be used as:

5 Public water supply

8 Air conditioning

11 Injection well

1 Domestic 3 Feedlot

6 Oil field water supply

9 Dewatering

12 Other (Specify below)

2 Irrigation 4 Industrial

7 Lawn and garden only

10 Observation well

Well's static water level 28 ft. below land surface measured on August month 30 day 1979 yearPump Test Data: NA Well water was ft. after hours pumping gpmEst. Yield NA gpm: Well water was ft. after hours pumping gpm

4. TYPE OF BLANK CASING USED:

1 Steel 3 RMP (SR)

5 Wrought iron

8 Concrete tile

Casing Joints: Glued Clamped 2 PVC 4 ABS

6 Asbestos-Cement

9 Other (specify below)

Welded

7 Fiberglass

10 Observation well

Threaded Blank casing dia 5 in. to 100 ft., Dia in. to ft., Dia in. to ft.Casing height above land surface 12 in., weight PSI 200 lbs./ft. Wall thickness or gauge No 40 schedule

TYPE OF SCREEN OR PERFORATION MATERIAL:

1 Steel 3 Stainless steel

5 Fiberglass

8 RMP (SR)

10 Asbestos-cement

2 Brass 4 Galvanized steel

6 Concrete tile

9 ABS

11 Other (specify)

Screen or Perforation Openings Are: 3 Mill slot 4 Key punched 5 Gauzed wrapped 8 Saw cut 11 None (open hole)1 Continuous slot 2 Louvered shutter 6 Wire wrapped 9 Drilled holes 4 Key punched 7 Torch cut 10 Other (specify) Screen-Perforation Dia 5 in. to 20 ft., Dia in. to ft., Dia in. to ft.Screen-Perforated Intervals: From 100 ft. to 120 ft., From ft. to ft., From ft. to ft.Gravel Pack Intervals: From 12 1/2 ft. to 120 ft., From ft. to ft., From ft. to ft.

From ft. to ft., From ft. to ft.

5. GROUT MATERIAL:

1 Neat cement

2 Cement grout

3 Bentonite

4 Other

Grouted Intervals: From 2 1/2 ft. to 12 1/2 ft., From ft. to ft., From ft. to ft., From ft. to ft.What is the nearest source of possible contamination: 1 Septic tank 4 Cess pool 7 Sewage lagoon 10 Fuel storage 14 Abandoned water well2 Sewer lines 5 Seepage pit 8 Feed yard 11 Fertilizer storage 15 Oil well/Gas well3 Lateral lines 6 Pit privy 9 Livestock pens 12 Insecticide storage 16 Other (specify below)Direction from well SW How many feet 600 ? Water Well Disinfected? Yes No Was a chemical/bacteriological sample submitted to Department? Yes No If yes, date sample was submitted month day year: Pump Installed? Yes No If Yes: Pump Manufacturer's name Model No. HP Volts

Depth of Pump Intake ft. Pumps Capacity rated at gal./min.

Type of pump: 1 Submersible 2 Turbine 3 Jet 4 Centrifugal 5 Reciprocating 6 Other

6. CONTRACTOR'S OR LANDOWNER'S CERTIFICATION:

This water well was (1) constructed, (2) reconstructed, or (3) plugged under my jurisdiction and was completed on August month 30 day 1979 yearand this record is true to the best of my knowledge and belief, Kansas Water Well Contractor's License No. 379This Water Well Record was completed on August month 31 day 1979 year under the businessname of 5 & 5 Drilling by (signature) Robert J. Hayes

7. LOCATE WELL'S LOCATION WITH AN "X" IN SECTION BOX:

FROM

TO

LITHOLOGIC LOG

FROM

TO

LITHOLOGIC LOG

0

2

Top Soil - Black

2

4

Clay Soft Brown

4

6

Lime Yellow Soft

6

9

Silt Brown

9

28

Lime Yellow Soft

28

57

Shale Hard Gray

57


Lime Yellow Coarse

94

107


107


114

Sand Hard White

114

120

Lime Hard Gray

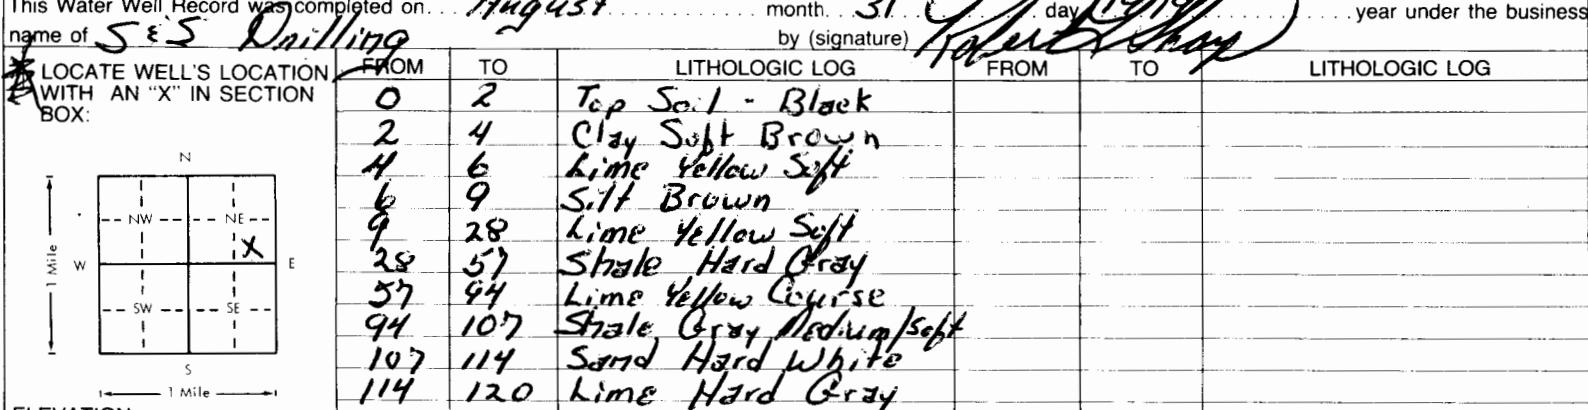

ELEVATION: Depth(s) Groundwater Encountered 1 ft. 2 ft. 3 ft. 4 ft. (Use a second sheet if needed)

INSTRUCTIONS: Use typewriter or ball point pen, please press firmly and PRINT clearly. Please fill in blanks, underline or circle the correct answers. Send top three copies to Kansas Department of Health and Environment, Division of Environment, Water Well Contractors, Topeka, KS 66620. Send one to WATER WELL OWNER and retain one for your records.