


USE TYPEWRITER OR BALL POINT PEN-PRESS FIRMLY, PRINT CLEARLY.

WATER WELL RECORD
KSA 82a-1201-1215

Kansas Department of Health and Environment-Division of Environment
(Water well Contractors)
Topeka, Kansas 66620

1. Location of well: County **BUTLER** Fraction **SE NW NW 1/4 SE 1/4 SE 1/4** Section number **29** Township number **T 24 S R 6 E** Range number **6**

2. Distance and direction from nearest town or city: **5 MI No. 2 E.**
Street address of well location if in city: **1 No. 1/2 E. FROM ELDORADO, KS.**
3. Owner of well: **JACK GREENE**
R.R. or street: **216 No. WACO**
City, state, zip code: **WICHITA, Ks. 67202**

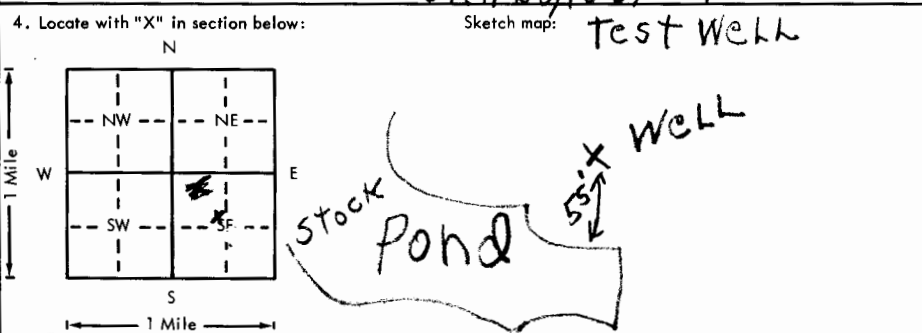

6. Bore hole dia. **6** in. Completion date **12-18-77**
Well depth **66** ft.

7. Cable tool Rotary Driven Dug
 Hollow rod Jetted Bored Reverse rotary

8. Use: Domestic Public supply Industry
 Irrigation Air conditioning Stock
 Lawn Oil field water Other

9. Casing: Material **PVC** Height: Above or below
Threaded Welded **GL** Surface **24** in.
RMP PVC Weight lbs./ft.
Dia. **5** in. to **66** ft. depth Wall Thickness: inches or
Dia. in. to ft. depth gage No. **258**

5. Type and color of material	From	To
TOP SOIL	0	2.5
Red CLAY	2.5	16
LIME Stone (WHITE)	16	37
SHALE (GRAY)	37	60
Limestone (WHITE)	60	66
(Use a second sheet if needed)		

10. Screen: Manufacturer's name **M.P.I.**

Type **P.V.C.** Dia. **5"**
Slot gauge **25/100** Length **10**
Set between **56** ft. and **66** ft.
ft. and ft.
Gravel pack? **YES** Size range of material **5/8**

11. Static water level: mo./day/yr.
11 ft. below land surface Date **12-19-77**

12. Pumping level below land surfaces:
 ft. after hrs. pumping g.p.m.
 ft. after hrs. pumping g.p.m.
Estimated maximum yield **75** g.p.m.

13. Water sample submitted: mo./day/yr.
 Yes No Date **12-11-77**

14. Well head completion: **P.V.C. CAP.**
 Pitless adapter Inches above grade

15. Well grouted? **YES**
With: Neat cement Bentonite Concrete
Depth: From **3** ft. to **14** ft.

16. Nearest source of possible contamination:
ft. **55** Direction **SO.** Type **Pond**
Well disinfected upon completion? Yes No

17. Pump: Not installed
Manufacturer's name _____
Model number _____ HP _____ Volts _____
Length of drop pipe _____ ft. capacity _____ g.p.m.
Type:
 Submersible Turbine
 Jet Reciprocating
 Centrifugal Other

18. Elevation:
Topography:
 Hill
 Slope
 Upland
 Valley

19. Remarks:
Test Well FOR WILD LIFE ESTATES.
WATER TEST WAS MADE BY WICHITA TEST LAB. WICHITA, KS.

20. Water well contractor's certification:
This well was drilled under my jurisdiction and this report is true to the best of my knowledge and belief.
Prewitt Const. Co. 353
Business name _____ License No. _____
Address **Box 744 Eldorado, Mo.**
Signed **Austin C. Prewitt** Date **12-19-77**
Authorized representative

24
60
29
SE
58
1/4
1/4
1/4
1/4