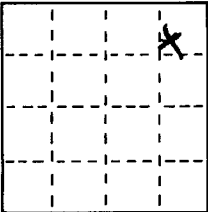
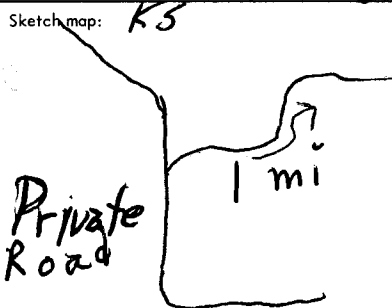


USE TYPEWRITER OR BALL
POINT PEN-PRESS FIRMLY,
PRINT CLEARLY.

WATER WELL RECORD
KSA 82a-1201-1215

T R EW sec 1/4 1/4 1/4 No.

Kansas State Dept. Of Health
(Water Well Contractors)
Forbes-Bldg. 740
Topeka, Kansas 66620

| 1 Location of well: | County GW | Township name 5 Salem | Fraction SW NE NE | Section number 25 | Town number 245 | Range number 8 E | | | | | | | | | | | | | | | | | | | | | | | | | | | | | | |
|---|------------------|--|--------------------------|---|------------------------|-------------------------|------------|-------------|------------|--------------------|------------|---------------------|-------------|-------------|--------------|-------------------|--------------|-------------|--------------|--------------------------------|--------------|--------------------------|--------------|--------------------------|--------------|----------------|--------------|--------------------------|--------------|-------------|---------------|----------------|--|--|--|--|
| Distance and direction from nearest town or city: 7 mi N | | | | 3 Owner of well: C Robert Buford | | | | | | | | | | | | | | | | | | | | | | | | | | | | | | | | |
| Street address of well location if in city: 9 1/2 W Eureka | | | | Address: Suite 200 - 202 W Douglas Wichita, KS 67202 | | | | | | | | | | | | | | | | | | | | | | | | | | | | | | | | |
| Locate with "X" in section below: N  W E S 1 Mile | | Sketch map: KS  | | 4 Well depth: 102 ft. Date of completion 5-22-75 Well diameter 8 in. | | | | | | | | | | | | | | | | | | | | | | | | | | | | | | | | |
| 2 Grade - 8 ft Type and color of material | | | | 5 <input checked="" type="checkbox"/> Cable tool <input type="checkbox"/> Rotary <input type="checkbox"/> Driven <input type="checkbox"/> Dug <input type="checkbox"/> Hollow rod <input type="checkbox"/> Jetted <input type="checkbox"/> Bored <input type="checkbox"/> Reverse rotary | | | | | | | | | | | | | | | | | | | | | | | | | | | | | | | | |
| | | | | 6 Use: <input checked="" type="checkbox"/> Domestic <input type="checkbox"/> Public supply <input type="checkbox"/> Industry <input type="checkbox"/> Irrigation <input type="checkbox"/> Air conditioning <input type="checkbox"/> Commercial <input type="checkbox"/> Test well <input type="checkbox"/> | | | | | | | | | | | | | | | | | | | | | | | | | | | | | | | | |
| | | | | 7 Casing: Material <input type="checkbox"/> Threaded <input type="checkbox"/> Welded <input checked="" type="checkbox"/> Surface 96 in. Dig. <input type="checkbox"/> Weight <input type="checkbox"/> lbs./ft. <input type="checkbox"/> 6 in. to 102 ft. depth Drive shoe? <input type="checkbox"/> Yes <input checked="" type="checkbox"/> No | | | | | | | | | | | | | | | | | | | | | | | | | | | | | | | | |
| | | | | 8 Screen: Manufacturer <input type="checkbox"/> Type None Dia. E Slot/gauze None Length <input type="checkbox"/> Set between <input type="checkbox"/> ft. and <input type="checkbox"/> ft. Fittings: <input checked="" type="checkbox"/> Yes <input type="checkbox"/> No Size range of material 4"-3/4" | | | | | | | | | | | | | | | | | | | | | | | | | | | | | | | | |
| | | | | 9 Static water level: 23 ft. below land surface Date 4-22-75 | | | | | | | | | | | | | | | | | | | | | | | | | | | | | | | | |
| <table border="1" style="width:100%; border-collapse: collapse;"> <thead> <tr> <th style="width:60%;">From</th> <th style="width:40%;">To</th> </tr> </thead> <tbody> <tr><td>Shale</td><td>0 2</td></tr> <tr><td>Lime</td><td>2 3</td></tr> <tr><td>Yellow Clay</td><td>3 4</td></tr> <tr><td>Shale + Lime</td><td>4 12</td></tr> <tr><td>Lime</td><td>12 15</td></tr> <tr><td>Blue Shale</td><td>15 25</td></tr> <tr><td>Lime</td><td>25 32</td></tr> <tr><td>Water Sand in Lime Seam</td><td>32 34</td></tr> <tr><td>Blue Shale + Lime</td><td>34 50</td></tr> <tr><td>Gray Shale + Lime</td><td>50 80</td></tr> <tr><td>Red Bed</td><td>80 88</td></tr> <tr><td>Lime + Blue Shale</td><td>88 92</td></tr> <tr><td>Lime</td><td>92 102</td></tr> <tr><td colspan="2" style="text-align:center;">TD 102'</td></tr> </tbody> </table> | | | | From | To | Shale | 0 2 | Lime | 2 3 | Yellow Clay | 3 4 | Shale + Lime | 4 12 | Lime | 12 15 | Blue Shale | 15 25 | Lime | 25 32 | Water Sand in Lime Seam | 32 34 | Blue Shale + Lime | 34 50 | Gray Shale + Lime | 50 80 | Red Bed | 80 88 | Lime + Blue Shale | 88 92 | Lime | 92 102 | TD 102' | | 10 Pumping level below land surfaces: ____ ft. after ____ hrs. pumping ____ g.p.m. ____ ft. after ____ hrs. pumping ____ g.p.m. Estimated maximum yield ____ g.p.m. | | |
| 11 Water sample submitted: <input type="checkbox"/> Yes <input checked="" type="checkbox"/> No Date ____ | | | | | | | | | | | | | | | | | | | | | | | | | | | | | | | | | | | | |
| 12 Well head completion: <input type="checkbox"/> Pitless adapter 96 <input type="checkbox"/> Inches above grade | | | | | | | | | | | | | | | | | | | | | | | | | | | | | | | | | | | | |
| 13 Well grouted? <input checked="" type="checkbox"/> Yes <input type="checkbox"/> No <input type="checkbox"/> Neat cement <input type="checkbox"/> Bentonite <input checked="" type="checkbox"/> Grout Depth: From ____ ft. to ____ ft. | | | | | | | | | | | | | | | | | | | | | | | | | | | | | | | | | | | | |
| 14 Nearest source of possible contamination: ft. 400 Direction E Type Lake Well disinfected upon completion? <input checked="" type="checkbox"/> Yes <input type="checkbox"/> No | | | | | | | | | | | | | | | | | | | | | | | | | | | | | | | | | | | | |
| 15 Pump: <input checked="" type="checkbox"/> Not installed Manufacturer's name ____ Model number ____ HP ____ Volts ____ Length of drop pipe ____ ft. capacity ____ g.p.m. Type: <input type="checkbox"/> Submersible <input type="checkbox"/> Turbine <input type="checkbox"/> Jet <input type="checkbox"/> Reciprocating <input type="checkbox"/> Centrifugal <input type="checkbox"/> Other | | | | | | | | | | | | | | | | | | | | | | | | | | | | | | | | | | | | |
| 16 Remarks: elevation In New house Basement | | | | 17 Water well contractor's certification: This well was drilled under my jurisdiction and this report is true to the best of my knowledge and belief. 9-5 Water Wells 301 Business name R R Uggel, KS License No. ____ Address ____ Signed David Sheeman Date 5-22-75 | | | | | | | | | | | | | | | | | | | | | | | | | | | | | | | | |

Forward the white, blue and pink copies to the Kansas State Dept. Of Health.

Form WWC-5