WATER WELL RECORD Form WWC-5 KSA 82a-1212

1 LOCATION OF WATER WELL: County: GREENWOOD | Fraction: NE ¼ SE ¼ NE ¼ | Section Number: 31 | Township Number: T 24 S | Range Number: R 9 E/W

Distance and direction from nearest town or city street address of well if located within city?
FROM HAMILTON KS - ON HW 99 - 4 S - 12 W - 2 S - 2½ W - 1 N - ½ W - ½ N - ½ W

2 WATER WELL OWNER: RICHARD AND MYRNA LANE
RR#, St. Address, Box # : 915 SHELDON
City, State, ZIP Code : EL DORADO KS 67042
Board of Agriculture, Division of Water Resources Application Number: –

3 LOCATE WELL'S LOCATION WITH AN "X" IN SECTION BOX:

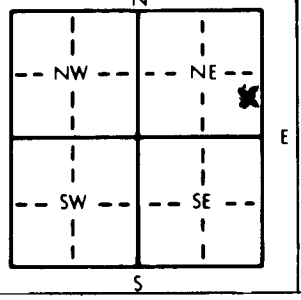

4 DEPTH OF COMPLETED WELL 35 ft. ELEVATION:
Depth(s) Groundwater Encountered 1. 18 ft. 2. – ft. 3. – ft.
WELL'S STATIC WATER LEVEL 11 ft. below land surface measured on mo/day/yr 07-11-90
Pump test data: Well water was 11 ft. after 1.5 hours pumping 12 gpm
Est. Yield 15 gpm: Well water was ft. after hours pumping gpm
Bore Hole Diameter 12.5 in. to 22 ft., and 8.625 in. to 35 ft.
WELL WATER TO BE USED AS: 1 Domestic 2 Irrigation 3 Feedlot 4 Industrial 5 Public water supply 6 Oil field water supply 7 Lawn and garden only 8 Air conditioning 9 Dewatering 10 Monitoring well 11 Injection well 12 Other (Specify below) –
Was a chemical/bacteriological sample submitted to Department? Yes ..... No X ; If yes, mo/day/yr sample was submitted –
Water Well Disinfected? Yes X No –

5 TYPE OF BLANK CASING USED: 1 Steel 2 PVC 3 RMP (SR) 4 ABS 5 Wrought iron 6 Asbestos-Cement 7 Fiberglass 8 Concrete tile 9 Other (specify below) –
CASING JOINTS: Glued X Clamped – Welded – Threaded –
Blank casing diameter 5 in. to 35 ft., Dia – in. to – ft., Dia – in. to – ft.
Casing height above land surface 36 in., weight lbs./ft. Wall thickness or gauge No.

TYPE OF SCREEN OR PERFORATION MATERIAL: 1 Steel 2 Brass 3 Stainless steel 4 Galvanized steel 5 Fiberglass 6 Concrete tile 7 PVC 8 RMP (SR) 9 ABS 10 Asbestos-cement 11 Other (specify) 12 None used (open hole)

SCREEN OR PERFORATION OPENINGS ARE: 1 Continuous slot 2 Louvered shutter 3 Mill slot 4 Key punched 5 Gauzed wrapped 6 Wire wrapped 7 Torch cut 8 Saw cut 9 Drilled holes 10 Other (specify) 11 None (open hole)

SCREEN-PERFORATED INTERVALS: From 17 ft. to 23 ft., From – ft. to – ft.
From – ft. to – ft., From – ft. to – ft.
GRAVEL PACK INTERVALS: From 11 ft. to 35 ft., From – ft. to – ft.
From – ft. to – ft., From – ft. to – ft.

6 GROUT MATERIAL: 1 Neat cement 2 Cement grout 3 Bentonite 4 Other –
Grout Intervals: From 3 ft. to 11 ft., From – ft. to – ft., From – ft. to – ft.

What is the nearest source of possible contamination:
1 Septic tank 2 Sewer lines 3 Watertight sewer lines 4 Lateral lines – NEW construction 5 Cess pool 6 Seepage pit 7 Pit privy 8 Sewage lagoon 9 Feedyard 10 Livestock pens 11 Fuel storage 12 Fertilizer storage 13 Insecticide storage STREAM - 120' - D.S 14 Abandoned water well 15 Oil well/Gas well 16 Other (specify below)
Direction from well? N W How many feet? 130' TO 300' - U.S.

FROM	TO	LITHOLOGIC LOG	FROM	TO	PLUGGING INTERVALS
0	18	CLAY SILT - MICRO SAND FILLED			
18	20	CLAY - SAND - SMALL GRAVEL			
20	22	LIME STONE - RUBBLE - CLAY			
22	35	SHALE - DARK TO LT. CHARCOAL			
		CAVE IN FROM 13 TO 20			
		OPEN HOLE BALE TEST +30 GPM			
		RECOMEND 15 GPM USE			
		GRAVEL PACK - 1750# PEA GRAVEL			

7 CONTRACTOR'S OR LANDOWNER'S CERTIFICATION: This water well was (1) constructed, (2) reconstructed, or (3) plugged under my jurisdiction and was completed on (mo/day/year) 07-10-90 and this record is true to the best of my knowledge and belief. Kansas Water Well Contractor's License No. 479 This Water Well Record was completed on (mo/day/yr) 07-13-90
under the business name of EBBERTS DRILLING by (signature) Shogan Ebbert

INSTRUCTIONS: Use typewriter or ball point pen. PLEASE PRESS FIRMLY and PRINT clearly. Please fill in blanks, underline or circle the correct answers. Send top three copies to Kansas Department of Health and Environment, Bureau of Water, Topeka, Kansas 66620-7320. Telephone: 913-296-5545. Send one to WATER WELL OWNER and retain one for your records.

OFFICE USE ONLY T R E/W SEC. ¼ ¼ ¼