


1 LOCATION OF WATER WELL: Sedgwick	FRACTION SE 1/4 SE 1/4 SW 1/4	Section Number 19	Township Number T 25 S	Range Number R 1E EAV
--	---	-----------------------------	----------------------------------	---------------------------------

Distance and direction from nearest town or city street address of well if located within city?
2310 W. 93rd North Wichita, Kansas

2 WATER WELL OWNER: LUSK COMPANY RR#, ST. ADDRESS, BOX #: 1608 E. Lewis CITY, STATE, ZIP CODE: Wichita, Kansas 67211	Board of Agriculture, Division of Water Resource Application Number:
---	---

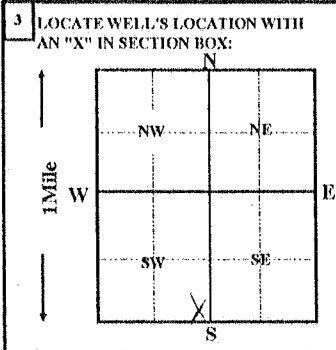

4 DEPTH OF COMPLETED WELL 50 ft. ELEVATION:	Depth(s) groundwater Encountered 1 ft. 2 ft. 3 ft.
WELL'S STATIC WATER LEVEL 32 FT. BELOW LAND SURFACE MEASURED ON 07/11/1995	
Pump test data: Well water was _____ ft. after _____ hours pumping _____ gpm	
Est. Yield _____ gpm: Well water was _____ ft. after _____ hours pumping _____ gpm	
Bore Hole Diameter _____ in. to _____ ft. and _____ in. to _____ ft.	
WELL WATER TO BE USED AS:	
1 Domestic 2 Irrigation 3 Feedlot 4 Industrial	5 Public water supply 6 Oil field water supply 7 Lawn and garden only 8 Air conditioning 9 Dewatering 10 Monitoring well 11 Injection well 12 Other (Specify below)
Was a chemical/bacteriological sample submitted to Department? Yes _____ No X ; If yes, mo/day/yr sample was submitted _____	Water Well Disinfected? Yes X No _____

5 TYPE OF CASING USED:	5 Wrought iron 6 Asbestos-Cement 7 Fiberglass	8 Concrete tile 9 Other (Specify below)	CASING JOINTS: Glued Clamped Welded Threaded
1 Steel 2 PVC 3 RMP (SR) 4 ABS			
Blank casing Diameter 6 in. to _____ ft., Dia _____ in. to _____ ft. weight _____ lbs. / ft.			
Casing height above land surface 12 in.,			Wall thickness or gauge No. _____
TYPE OF SCREEN OR PERFORATION MATERIAL:	1 Steel 2 Brass 3 Stainless Steel 4 Galvanized steel	5 Fiberglass 6 Concrete tile	7 PVC 8 RMP (SR) 9 ABS 10 Asbestos-cement 11 other (specify) N/A 12 None used (open hole)
SCREEN OR PERFORATION OPENING ARE:	1 Continuous slot 2 Louvered shutter 3 Mill slot 4 Key punched	5 Gauzed wrapped 6 Wire wrapped 7 Torch cut	8 Saw cut 9 Drilled holes 10 Other (specify) N/A 11 None (open hole)
SCREEN-PERFORATION INTERVALS:	from _____ ft. to _____ ft.	ft., From _____ ft. to _____ ft.	ft. to _____ ft.
GRAVEL PACK INTERVALS:	from _____ ft. to _____ ft.	ft., From _____ ft. to _____ ft.	ft. to _____ ft.

6 GROUT MATERIAL: 1 Neat cement	2 Cement grout	3 Bentonite	4 Other
Grout Intervals: From 1 ft. to 12 ft. From _____ ft. to _____ ft.			
What is the nearest source of possible contamination:	1 Septic tank 2 Sewer lines 3 Watertight sewer lines	4 Lateral lines 5 Cess pool 6 Seepage pit	7 Pit privy 8 Sewage lagoon 9 Feedyard 10 Livestock pens 11 Fuel storage 12 Fertilizer storage 13 Insecticide storage 14 Abandon water well 15 Oil well/Gas well 16 Other (specify below) None Apparent

FROM	TO	LITHOLOGIC LOG	FROM	TO	PLUGGING INTERVALS
			0	1	surface materials
			1	12	cement grout
			12	32	bentonite hole plug
			32	50	chlorinated sand and gravel

7 CONTRACTOR'S OR LANDOWNER'S CERTIFICATION: This water well was (1) constructed, (2) reconstructed, or (3) plugged under my jurisdiction and was completed on (mo/day/year) **07/11/1995** and this record is true to the best of my knowledge and belief. Kansas Water Well Contractor's License No. **236** This Water Well Record was completed on (mo/day/yr) **07/17/95** Under the business name of **Harp Well & Pump Service, Inc.** by (signature) *Jane Frederick*