

MW-10 2311026


1 LOCATION OF WATER WELL: County: <u>SEDGWICK</u>	Fraction <u>NE 1/4 NE 1/4 NE 1/4</u>	Section Number <u>5</u>	Township Number <u>T 25 S</u>	Range Number <u>R 1 EW</u>
--	---	----------------------------	----------------------------------	-------------------------------

Distance and direction from nearest town or city street address of well if located within city?
125th STREET NORTH AND OLD HIGHWAY 81 INTERSECTION

2 WATER WELL OWNER: KDHE
 RR#, St. Address, Box #: FORBES FIELD BUILDING 740
 City, State, ZIP Code: TOPEKA, KS 66620

Board of Agriculture, Division of Water Resources
 Application Number:

3 LOCATE WELL'S LOCATION WITH AN "X" IN SECTION BOX:

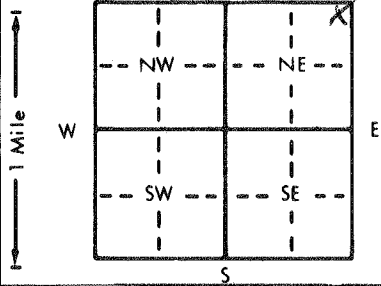

4 DEPTH OF COMPLETED WELL: 22 ft. ELEVATION: _____

Depth(s) Groundwater Encountered 16.67 ft. 17 ft. _____ ft. _____ ft.

WELL'S STATIC WATER LEVEL: 16.67 ft. below land surface measured on mo/day/yr 8-11-95

Pump test data: Well water was _____ ft. after _____ hours pumping _____ gpm

Est. Yield _____ gpm; Well water was _____ ft. after _____ hours pumping _____ gpm

Bore Hole Diameter: 8 in. to _____ ft., and _____ in. to _____ ft.

WELL WATER TO BE USED AS:

5 Public water supply	8 Air conditioning	11 Injection well
1 Domestic	3 Feedlot	6 Oil field water supply
2 Irrigation	4 Industrial	7 Lawn and garden only
		<u>10 Monitoring well</u>

Was a chemical/bacteriological sample submitted to Department? Yes _____ No X; If yes, mo/day/yr sample was submitted _____

Water Well Disinfected? Yes _____ No X

5 TYPE OF BLANK CASING USED:

1 Steel	3 RMP (SR)	6 Asbestos-Cement	9 Other (specify below)
<u>2 PVC</u>	4 ABS	7 Fiberglass	

CASING JOINTS: Glued _____ Clamped _____
 Welded _____
Threaded FLUSH

Blank casing diameter: 2 in. to _____ ft., Dia _____ in. to _____ ft., Dia _____ in. to _____ ft.

Casing height above land surface: FLUSH in., weight 703 lbs./ft. Wall thickness or gauge No. 154

TYPE OF SCREEN OR PERFORATION MATERIAL:

1 Steel	3 Stainless steel	5 Fiberglass	8 RMP (SR)	10 Asbestos-cement
2 Brass	4 Galvanized steel	6 Concrete tile	9 ABS	11 Other (specify)
				12 None used (open hole)

7 PVC

SCREEN OR PERFORATION OPENINGS ARE:

1 Continuous slot	<u>3 Mill slot</u>	5 Gauzed wrapped	8 Saw cut	11 None (open hole)
2 Louvered shutter	4 Key punched	6 Wire wrapped	9 Drilled holes	
		7 Torch cut	10 Other (specify)	

SCREEN-PERFORATED INTERVALS: From 12 ft. to 22 ft., From _____ ft. to _____ ft.

GRAVEL PACK INTERVALS: From 10 ft. to 22 ft., From _____ ft. to _____ ft.

6 GROUT MATERIAL:

1 Neat cement	2 Cement grout	<u>3 Bentonite</u>	4 Other
---------------	----------------	--------------------	---------

Grout Intervals: From 10 ft. to 2.5 ft., From _____ ft. to _____ ft., From _____ ft. to _____ ft.

What is the nearest source of possible contamination:

1 Septic tank	4 Lateral lines	7 Pit privy	<u>11 Fuel storage</u>	10 Livestock pens	14 Abandoned water well
2 Sewer lines	5 Cess pool	8 Sewage lagoon	12 Fertilizer storage	15 Oil well/Gas well	
3 Watertight sewer lines	6 Seepage pit	9 Feedyard	13 Insecticide storage	16 Other (specify below)	

Direction from well? NORTHEAST How many feet? 400

FROM	TO	LITHOLOGIC LOG	FROM	TO	PLUGGING INTERVALS
0	3.0	CLAY, V. SILTY, SAND			
3.0	7.0	CLAY, V. SILTY, LITTLE SAND			
7.0	12.5	CLAY, V. SILTY, WITH SAND			
12.5	22.0	SAND			

7 CONTRACTOR'S OR LANDOWNER'S CERTIFICATION: This water well was (1) constructed (2) reconstructed, or (3) plugged under my jurisdiction and was completed on (mo/day/year) 8-11-95 and this record is true to the best of my knowledge and belief. Kansas Water Well Contractor's License No. 531 This Water Well Record was completed on (mo/day/yr) 8-17-95 under the business name of GSI by (signature) Steve Nudler