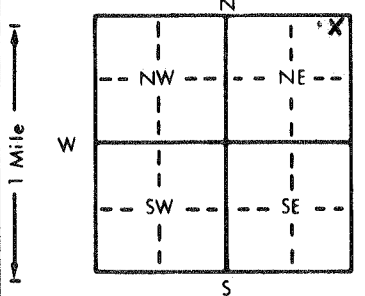


MW-7 2311026

1 LOCATION OF WATER WELL: County: <u>SEDGWICK</u>	Fraction <u>NE 1/4 NE 1/4 NE 1/4</u>	Section Number <u>5</u>	Township Number <u>T 25 S</u>	Range Number <u>R 1 EW</u>
------------------------------------------------------	-----------------------------------------	----------------------------	----------------------------------	-------------------------------

Distance and direction from nearest town or city street address of well if located within city?
125th STREET NORTH AND OLD HIGHWAY 81 INTERSECTION

2 WATER WELL OWNER: KDHE
 RR#, St. Address, Box # : FORBES FIELD BUILDING 740
 City, State, ZIP Code : TOPEKA, KS 66620
 Board of Agriculture, Division of Water Resources
 Application Number:

3 LOCATE WELL'S LOCATION WITH AN "X" IN SECTION BOX:


4 DEPTH OF COMPLETED WELL: 22' ft. ELEVATION:
 Depth(s) Groundwater Encountered 1. 15' ft. 2. ft. 3. ft.
 WELL'S STATIC WATER LEVEL 15.75 ft. below land surface measured on mo/day/yr 8-11-95
 Pump test data: Well water was ft. after hours pumping gpm
 Est. Yield gpm: Well water was ft. after hours pumping gpm
 Bore Hole Diameter 8 in. to ft., and in. to ft.
 WELL WATER TO BE USED AS:
 5 Public water supply 8 Air conditioning 11 Injection well
 1 Domestic 3 Feedlot 6 Oil field water supply 9 Dewatering 12 Other (Specify below)
 2 Irrigation 4 Industrial 7 Lawn and garden only 10 Monitoring well
 Was a chemical/bacteriological sample submitted to Department? Yes No X; If yes, mo/day/yr sample was submitted
 Water Well Disinfected? Yes No X

5 TYPE OF BLANK CASING USED:
 1 Steel 3 RMP (SR) 5 Wrought iron 8 Concrete tile CASING JOINTS: Glued Clamped
 2 PVC 4 ABS 6 Asbestos-Cement 9 Other (specify below) Welded
 7 Fiberglass Treaded FLUSH
 Blank casing diameter 2 in. to ft., Dia in. to ft., Dia in. to ft.
 Casing height above land surface FLUSH in., weight 703 lbs./ft. Wall thickness or gauge No. 154
 TYPE OF SCREEN OR PERFORATION MATERIAL:
 1 Steel 3 Stainless steel 5 Fiberglass 8 RMP (SR) 10 Asbestos-cement
 2 Brass 4 Galvanized steel 6 Concrete tile 9 ABS 11 Other (specify)
 12 None used (open hole)
 SCREEN OR PERFORATION OPENINGS ARE:
 1 Continuous slot 3 3 Mill slot 5 Gauzed wrapped 8 Saw cut 11 None (open hole)
 2 Louvered shutter 4 Key punched 6 Wire wrapped 9 Drilled holes
 7 Torch cut 10 Other (specify)
 SCREEN-PERFORATED INTERVALS: From 12 ft. to 22 ft., From ft. to ft.
 From ft. to ft., From ft. to ft.
 GRAVEL PACK INTERVALS: From 10 ft. to 22 ft., From ft. to ft.
 From ft. to ft., From ft. to ft.

6 GROUT MATERIAL: 1 Neat cement 2 Cement grout 3 Bentonite 4 Other
 Grout Intervals: From 10 ft. to 1.5 ft., From ft. to ft., From ft. to ft.
 What is the nearest source of possible contamination:
 1 Septic tank 4 Lateral lines 7 Pit privy 10 Livestock pens 14 Abandoned water well
 2 Sewer lines 5 Cess pool 8 Sewage lagoon 11 Fuel storage 15 Oil well/Gas well
 3 Watertight sewer lines 6 Seepage pit 9 Feedyard 12 Fertilizer storage 16 Other (specify below)
 13 Insecticide storage
 Direction from well? EAST NORTHEAST How many feet? 600

FROM	TO	LITHOLOGIC LOG	FROM	TO	PLUGGING INTERVALS
0	1.0	CLAY, SILTY			
1.0	3.0	CLAY, V. SILTY			
3.0	9.0	SILT, SAND			
9.0	18.0	SAND, CLAYEY, SILTY, SOME GRAVEL			
18.0	22.0	SAND			

7 CONTRACTOR'S OR LANDOWNER'S CERTIFICATION: This water well was (1) constructed (2) reconstructed, or (3) plugged under my jurisdiction and was completed on (mo/day/year) 8-11-95 and this record is true to the best of my knowledge and belief. Kansas Water Well Contractor's License No. 531 This Water Well Record was completed on (mo/day/yr) 8-17-95 under the business name of GSI by (signature) Steve Nessler