

MW-13 2311026


WATER WELL RECORD Form WWC-5 KSA 82a-1212

1 LOCATION OF WATER WELL: Fraction NE 1/4 NE 1/4 NE 1/4 Section Number 5 Township Number T 25 S Range Number R 1 EW

Distance and direction from nearest town or city street address of well if located within city? 125th STREET NORTH AND OLD HIGHWAY 81 INTERSECTION

2 WATER WELL OWNER: KDHE RR#, St. Address, Box #: FORBES FIELD BUILDING 740 City, State, ZIP Code: TOPEKA, KS 66620 Board of Agriculture, Division of Water Resource Application Number:

3 LOCATE WELL'S LOCATION WITH AN "X" IN SECTION BOX:

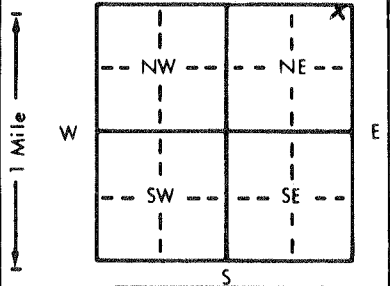

4 DEPTH OF COMPLETED WELL: 23 ft. ELEVATION: 16 ft.

WELL'S STATIC WATER LEVEL: 18.13 ft. below land surface measured on mo/day/yr 8-11-95. Pump test data: Well water was ... gpm. Est. Yield ... gpm. Bore Hole Diameter: 8 in. to ... ft. WELL WATER TO BE USED AS: 5 Public water supply, 8 Air conditioning, 11 Injection well, 12 Other (Specify below) Monitoring well. Was a chemical/bacteriological sample submitted to Department? Yes ... No ... X. If yes, mo/day/yr sample was submitted. Water Well Disinfected? Yes ... No ... X.

5 TYPE OF BLANK CASING USED: 1 Steel, 2 PVC, 3 RMP (SR), 4 ABS, 5 Wrought iron, 6 Asbestos-Cement, 7 Fiberglass, 8 Concrete tile, 9 Other (specify below), 10 Asbestos-cement, 11 Other (specify), 12 None used (open hole). CASING JOINTS: Glued, Clamped, Welded, Threaded, FLUSH.

Blank casing diameter: 2 in. to ... ft. Dia. in. to ... ft. Dia. in. to ... ft. Casing height above land surface: FLUSH in., weight: .703 lbs./ft. Wall thickness or gauge No.: 154.

TYPE OF SCREEN OR PERFORATION MATERIAL: 1 Steel, 2 Brass, 3 Stainless steel, 4 Galvanized steel, 5 Fiberglass, 6 Concrete tile, 7 PVC, 8 RMP (SR), 9 ABS, 10 Asbestos-cement, 11 Other (specify), 12 None used (open hole).

SCREEN OR PERFORATION OPENINGS ARE: 1 Continuous slot, 2 Louvered shutter, 3 Mill slot, 4 Key punched, 5 Gauzed wrapped, 6 Wire wrapped, 7 Torch cut, 8 Saw cut, 9 Drilled holes, 10 Other (specify), 11 None (open hole).

SCREEN-PERFORATED INTERVALS: From 13 ft. to 23 ft. GRAVEL PACK INTERVALS: From 11 ft. to 23 ft.

6 GROUT MATERIAL: 1 Neat cement, 2 Cement grout, 3 Bentonite, 4 Other. Grout Intervals: From 11 ft. to 1-5 ft. to ... ft. to ... ft.

What is the nearest source of possible contamination: 1 Septic tank, 2 Sewer lines, 3 Watertight sewer lines, 4 Lateral lines, 5 Cess pool, 6 Seepage pit, 7 Pit privy, 8 Sewage lagoon, 9 Feedyard, 10 Livestock pens, 11 Fuel storage, 12 Fertilizer storage, 13 Insecticide storage, 14 Abandoned water well, 15 Oil well/Gas well, 16 Other (specify below). Direction from well? NORTH EAST How many feet? 260

Table with columns: FROM, TO, LITHOLOGIC LOG, FROM, TO, PLUGGING INTERVALS. Rows show depth intervals and lithology: 0-3.0 CLAY, V. SILTY, SOME SAND; 3.0-11.5 CLAY, SILTY, SOME SAND; 11.5-15.0 SAND, V. CLAYEY, SILTY; 15.0-17.0 CLAY, SILTY; 17.0-20.0 SAND, SILTY; 20.0-23.0 SAND, SILTY, SOME FINE GRAVEL.

7 CONTRACTOR'S OR LANDOWNER'S CERTIFICATION: This water well was (1) constructed, (2) reconstructed, or (3) plugged under my jurisdiction and was completed on (mo/day/year) 8-11-95 and this record is true to the best of my knowledge and belief. Kansas Water Well Contractor's License No. 531 This Water Well Record was completed on (mo/day/yr) 8-17-95 under the business name of GSI by (signature) Steve Nudler