


1 LOCATION OF WATER WELL: Sedgwick	FRACTION NW 1/4 NW 1/4 SW 1/4	Section Number 13	Township Number T 25 S	Range Number R 1E E/W
--	---	-----------------------------	----------------------------------	---------------------------------

Distance and direction from nearest town or city street address of well if located within city?

1/2 North of 101st, Eastside of Oliver, 150' East Wichita, Kansas

2 WATER WELL OWNER: CLARK, George Land Co.	RR#, ST. ADDRESS, BOX #: 2551 Greenleaf	Board of Agriculture, Division of Water Resource
CITY, STATE, ZIP CODE: Wichita, Kansas		Application Number: 67226

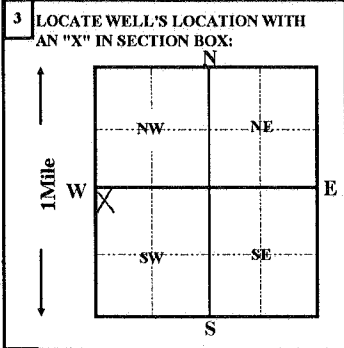

4 DEPTH OF COMPLETED WELL 40 ft. ELEVATION:	
Depth(s) groundwater Encountered 1 ft.	2 ft. 3 ft.
WELL'S STATIC WATER LEVEL 19 FT. BELOW LAND SURFACE MEASURED ON 01/09/1996	
Pump test data: Well water was ft. after hours pumping gpm	
Est. Yield gpm: Well water was ft. after hours pumping gpm	
Bore Hole Diameter 12 in. to 40 ft. and in. to ft.	
WELL WATER TO BE USED AS:	
1 Domestic	3 Feedlot
2 Irrigation	4 Industrial
5 Public water supply	6 Oil field water supply
7 Lawn and garden only	8 Air conditioning
9 Dewatering	10 Monitoring well
11 Injection well	12 Other (Specify below)
Was a chemical/bacteriological sample submitted to Department? Yes <input type="checkbox"/> No <input checked="" type="checkbox"/> ; If yes, mo/day/yr sample was submitted Water Well Disinfected? Yes <input checked="" type="checkbox"/> No <input type="checkbox"/>	

5 TYPE OF CASING USED:		5 Wrought iron	8 Concrete tile	CASING JOINTS:	
1 Steel	3 RMP (SR)	6 Asbestos-Cement	9 Other (Specify below)	Glued <input checked="" type="checkbox"/>	Clamped
2 PVC	4 ABS	7 Fiberglass	SDR-26	Welded	
Blank casing Diameter 5 in. to 24 ft., Dia	in. to ft.	weight 2.35 lbs. / ft.	Wall thickness or gauge No. .214		
Casing height above land surface 12 in.,					
TYPE OF SCREEN OR PERFORATION MATERIAL:		5 Fiberglass	8 RMP (SR)	11 other (specify)	
1 Steel	3 Stainless Steel	6 Concrete tile	9 ABS	12 None used (open hole)	
2 Brass	4 Galvanized steel			11 None (open hole)	
SCREEN OR PERFORATION OPENING ARE:		5 Gauzed wrapped	8 Saw cut		
1 Continous slot	3 Mill slot	6 Wire wrapped	9 Drilled holes		
2 Louvered shutter	4 Key punched	7 Torch cut	10 Other (specify)		
SCREEN-PERFORATION INTERVALS:		from 24 ft. to 40 ft., From	ft. to	ft.	
GRAVEL PACK INTERVALS:		from 24 ft. to 40 ft., From	ft. to	ft.	

6 GROUT MATERIAL:		1 Neat cement	2 Cement grout	3 Bentonite	4 Other
Grout Intervals: From 4 ft. to 24 ft. From		ft. to		ft. From	
What is the nearest source of possible contamination:		10 Livestock pens	14 Abandon water well		
1 Septic tank	4 Lateral lines	7 Pit privy	11 Fuel storage	15 Oil well/Gas well	
2 Sewer lines	5 Cess pool	8 Sewage lagoon	12 Fertilizer storage	16 Other (specify below)	
3 Watertight sewer lines	6 Seepage pit	9 Feedyard	13 Insecticide storage	None Apparent	

Direction from well?		How many feet?				
FROM	TO	LITHOLOGIC LOG		FROM	TO	PLUGGING INTERVALS
0	4	topsoil				
4	20	clay				
20	40	medium fine sand				

7 CONTRACTOR'S OR LANDOWNER'S CERTIFICATION: This water well was (1) constructed, (2) reconstructed, or (3) plugged under my jurisdiction and was completed on (mo/day/year) **01/09/1996** and this record is true to the best of my knowledge and belief. Kansas Water Well Contractor's License No. **236** This Water Well Record was completed on (mo/day/yr) **01/11/96** Under the business name of **Harp Well & Pump Service, Inc.** by (signature) *Jane Frederick*