


1 LOCATION OF WATER WELL: Sedgwick	FRACTION NW 1/4 SE 1/4 SW 1/4	Section Number 31	Township Number T 25 S	Range Number R 1E E/W
--	---	-----------------------------	----------------------------------	---------------------------------

Distance and direction from nearest town or city street address of well if located within city?

400 S. Dexter Valley Center, Kansas

2 WATER WELL OWNER: STECK, Richard	Board of Agriculture, Division of Water Resource
RR#, ST. ADDRESS, BOX #: 400 S. Dexter	Application Number:
CITY, STATE, ZIP CODE: Valley Center, Kansas	

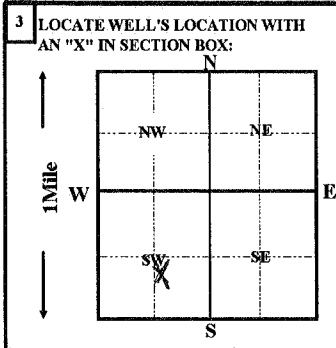

4 DEPTH OF COMPLETED WELL 35 ft.	ELEVATION:		
Depth(s) groundwater Encountered	1 ft.	2 ft.	3 ft.
WELL'S STATIC WATER LEVEL	20	FT. BELOW LAND SURFACE MEASURED ON 02/29/1996	
Pump test data:	Well water was	ft. after	hours pumping
Est. Yield	gpm:	Well water was	ft. after
Bore Hole Diameter	12 in. to 35	ft. and	in. to
WELL WATER TO BE USED AS:	5 Public water supply	8 Air conditioning	11 Injection well
	1 Domestic	3 Feedlot	6 Oil field water supply
	2 Irrigation	4 Industrial	7 Lawn and garden only
		9 Dewatering	12 Other (Specify below)
Was a chemical/bacteriological sample submitted to Department? Yes		No X ; If yes, mo/day/yr sample was submitted	
Water Well Disinfected? Yes X		No	

5 TYPE OF CASING USED:	5 Wrought iron	8 Concrete tile	CASING JOINTS: Glued X Clamped
1 Steel	3 RMP (SR)	6 Asbestos-Cement	9 Other (Specify below)
2 PVC	4 ABS	7 Fiberglass	SDR-26
Blank casing Diameter	5 in. to 24	ft., Dia	in. to
Casing height above land surface	12 in.,	weight 2.35 lbs./ft.	Wall thickness or gauge No. .214
TYPE OF SCREEN OR PERFORATION MATERIAL:		7 PVC	10 Asbestos-cement
1 Steel	3 Stainless Steel	5 Fiberglass	8 RMP (SR)
2 Brass	4 Galvanized steel	6 Concrete tile	9 ABS
SCREEN OR PERFORATION OPENING ARE:		5 Gauzed wrapped	8 Saw cut
1 Continous slot	3 Mill slot	6 Wire wrapped	9 Drilled holes
2 Louvered shutter	4 Key punched	7 Torch cut	10 Other (specify)
SCREEN-PERFORATION INTERVALS:	from 24 ft. to 35 ft., From	ft. to	ft. to
GRAVEL PACK INTERVALS:	from 24 ft. to 35 ft., From	ft. to	ft. to

6 GROUT MATERIAL: 1 Neat cement	2 Cement grout	3 Bentonite	4 Other bentonite hole plug
Grout Intervals: From 4 ft. to 24 ft. From	ft. From	ft. to	ft. From
What is the nearest source of possible contamination:		10 Livestock pens	14 Abandon water well
1 Septic tank	4 Lateral lines	7 Pit privy	11 Fuel storage
2 Sewer lines	5 Cess pool	8 Sewage lagoon	12 Fertilizer storage
3 Watertight sewer lines	6 Seepage pit	9 Feedyard	13 Insecticide storage
			None Apparent

FROM	TO	LITHOLOGIC LOG	FROM	TO	PLUGGING INTERVALS
0	2	topsoil			
2	15	clay			
15	20	fine sand			
20	35	medium coarse sand			

7 CONTRACTOR'S OR LANDOWNER'S CERTIFICATION: This water well was (1) constructed, (2) reconstructed, or (3) plugged under my jurisdiction and was completed on (mo/day/year) **02/29/1996** and this record is true to the best of my knowledge and belief. Kansas Water Well Contractor's License No. **236** This Water Well Record was completed on (mo/day/yr) **03/01/96**

Under the business name of **Harp Well & Pump Service, Inc.** by (signature) *Jane Frederick*