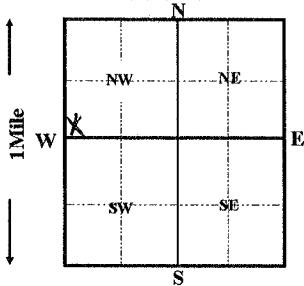


1 LOCATION OF WATER WELL: Sedgwick	FRACTION SW 1/4 SW 1/4 NW 1/4	Section Number 31	Township Number T 25 S	Range Number R 1E E/W
--	---	-----------------------------	----------------------------------	---------------------------------

Distance and direction from nearest town or city street address of well if located within city?

126 N. Main Valley Center, Kansas

2 WATER WELL OWNER: GARTENS MUSIC	Board of Agriculture, Division of Water Resource
RR#, ST. ADDRESS, BOX #: 126 N. Main	Application Number:
CITY, STATE, ZIP CODE: Valley Center, Kansas	

3 LOCATE WELL'S LOCATION WITH AN "X" IN SECTION BOX: 	4 DEPTH OF COMPLETED WELL 35 ft. ELEVATION:
	Depth(s) groundwater Encountered 1 ft. 2 ft. 3 ft.
	WELL'S STATIC WATER LEVEL 15 FT. BELOW LAND SURFACE MEASURED ON 03/29/1996 Pump test data: Well water was ft. after hours pumping gpm Est. Yield gpm: Well water was ft. after hours pumping gpm Bore Hole Diameter 12 in. to 35 ft. and in. to ft. WELL WATER TO BE USED AS: 5 Public water supply 8 Air conditioning 11 Injection well 1 Domestic 3 Feedlot 6 Oil field water supply 9 Dewatering 12 Other (Specify below) 2 Irrigation 4 Industrial 7 Lawn and garden only 10 Monitoring well

5 TYPE OF CASING USED:	5 Wrought iron	8 Concrete tile	CASING JOINTS: Glued <input checked="" type="checkbox"/> Clamped
1 Steel 3 RMP (SR)	6 Asbestos-Cement	9 Other (Specify below)	Welded
2 PVC 4 ABS	7 Fiberglass	SDR-26	Threaded
Blank casing Diameter 5 in. to 25 ft., Dia in. to ft., Dia in. to ft.			
Casing height above land surface 12 in., weight 2.35 lbs./ft. Wall thickness or gauge No. .214			
TYPE OF SCREEN OR PERFORATION MATERIAL:	7 PVC	10 Asbestos-cement	
1 Steel 3 Stainless Steel 5 Fiberglass	8 RMP (SR)	11 other (specify)	
2 Brass 4 Galvanized steel 6 Concrete tile 9 ABS		12 None used (open hole)	
SCREEN OR PERFORATION OPENING ARE:	5 Gauzed wrapped	8 Saw cut	11 None (open hole)
1 Continuous slot 3 Mill slot 6 Wire wrapped	7 Torch cut	9 Drilled holes	
2 Louvered shutter 4 Key punched		10 Other (specify)	
SCREEN-PERFORATION INTERVALS: from 25 ft. to 35 ft., From ft. to ft.			
GRAVEL PACK INTERVALS: from 24 ft. to 35 ft., From ft. to ft.			

6 GROUT MATERIAL: 1 Neat cement 2 Cement grout 3 Bentonite 4 Other
Grout Intervals: From 4 ft. to 24 ft. From ft. to ft.
What is the nearest source of possible contamination:
1 Septic tank 4 Lateral lines 7 Pit privy 10 Livestock pens 14 Abandon water well
2 Sewer lines 5 Cess pool 8 Sewage lagoon 11 Fuel storage 15 Oil well/Gas well
3 Watertight sewer lines 6 Seepage pit 9 Feedyard 12 Fertilizer storage 16 Other (specify below)
13 Insecticide storage

Direction from well? **West** How many feet? **75**

FROM	TO	LITHOLOGIC LOG	FROM	TO	PLUGGING INTERVALS
0	2	topsoil			
2	5	sandy clay			
5	35	medium to coarse sand and gravel			

7 CONTRACTOR'S OR LANDOWNER'S CERTIFICATION: This water well was (1) constructed, (2) reconstructed, or (3) plugged under my jurisdiction and was completed on (mo/day/year) 03/29/1996 and this record is true to the best of my knowledge and belief. Kansas Water Well Contractor's License No. 236 This Water Well Record was completed on (mo/day/yr) 04/01/96 Under the business name of Harp Well & Pump Service, Inc by (signature) <i>Jane Frederick</i>
