


1 LOCATION OF WATER WELL: Sedgwick	FRACTION NE 1/4 NE 1/4 SW 1/4	Section Number 31	Township Number T 25 S	Range Number R 1E E/W
--	---	-----------------------------	----------------------------------	---------------------------------

Distance and direction from nearest town or city street address of well if located within city?

120 S. Miles Ave. Valley Center, Kansas

WATER WELL OWNER: WHITE, Mildred M.	Board of Agriculture, Division of Water Resource
RR#, ST. ADDRESS, BOX #: 120 S. Miles Ave.	Application Number:
CITY, STATE, ZIP CODE: Valley Center, Kansas 67147	

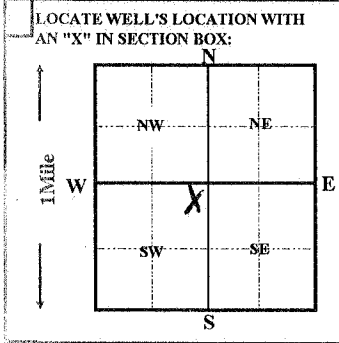

4 DEPTH OF CONCRETE WELL 23 ft.	ELEVATION: 3 ft.
Depth(s) groundwater Encountered 1 ft.	FT. BELOW LAND SURFACE MEASURED ON 07/11/1996 mo/day/yr
WELL'S STATIC WATER LEVEL 13	
Pump test data:	Well water was
Est. Yield	gpm: Well water was
Bore Hole Diameter	unknown in. to
WELL WATER USED AS:	5 Public water supply
1 Domestic	3 Feedlot
2 Irrigation	4 Industrial
	6 Oil field water supply
	7 Lawn and garden only
	8 Air conditioning
	9 Dewatering
	10 Monitoring well
	11 Injection well
	12 Other (Specify below)
Was a chemical/bacteriological sample submitted to Department? Yes	No X ; If yes, mo/day/yr sample was submitted
Water Well Disinfected?	Yes X No

5 TYPE OF CASING USED:	5 Wrought iron	8 Concrete tile	CASING JOINTS:	Glued	Clamped
1 Steel	3 RMP (SR)	6 Asbestos-Cement	9 Other (Specify below)	Welded	
2 PVC	4 ABS	7 Fiberglass		Threaded	
Blank casing Diameter	5 in. to	ft., Dia	in. to	ft., Dia	in. to
Casing height above land surface	12 in., weight	lbs. / ft.	Wall thickness or gauge No.		
TYPE OF SCREEN OR PERFORATION MATERIAL:	5 Fiberglass	8 RMP (SR)	10 Asbestos-cement		
1 Steel	3 Stainless Steel	6 Concrete tile	9 ABS	11 other (specify)	N/A
2 Brass	4 Galvanized steel			12 None used (open hole)	
SCREEN OR PERFORATION OPENING ARE:	5 Gauzed wrapped	8 Saw cut		11 None (open hole)	
1 Continuous slot	3 Mill slot	6 Wire wrapped		9 Drilled holes	
2 Louvered shutter	4 Key punched	7 Torch cut		10 Other (specify)	N/A
SCREEN-PERFORATION INTERVALS:	from	ft. to	ft., From	ft. to	ft.
GRAVEL PACK INTERVALS:	from	ft. to	ft., From	ft. to	ft.

6 GROUT MATERIAL:	1 Neat cement	2 Cement grout	3 Bentonite	4 Other
Grout Intervals:	From 0 ft. to 13	ft. From	ft. to	ft. From
What is the nearest source of possible contamination:				
1 Septic tank	4 Lateral lines	7 Pit privy	10 Livestock pens	14 Abandon water well
2 Sewer lines	5 Cess pool	8 Sewage lagoon	11 Fuel storage	15 Oil well/Gas well
3 Watertight sewer lines	6 Seepage pit	9 Feedyard	12 Fertilizer storage	16 Other (specify below)
			13 Insecticide storage	

Direction from well?	East	How many feet?	20
FROM	TO	LITHOLOGIC LOG	PLUGGING INTERVALS
			cement grout
			chlorinated sand and gravel

7 CONTRACTOR'S OR LANDOWNER'S CERTIFICATION: This water well was (1) constructed, (2) reconstructed, or (3) plugged under my jurisdiction and was completed on (mo/day/year) **07/11/1996** and this record is true to the best of my knowledge and belief. Kansas Water Well Contractor's License No. **236** This Water Well Record was completed on (mo/day/yr) **07/12/96** Under the business name of **Harp Well & Pump Service, Inc** by (signature) **Todd S. Harp**