


1 LOCATION OF WATER WELL: Sedgwick	FRACTION NW 1/4 NE 1/4 NW 1/4	Section Number 29	Township Number T 25 S	Range Number R 1E E/W
--	---	-----------------------------	----------------------------------	---------------------------------

Distance and direction from nearest town or city street address of well if located within city?
601 W. 93rd N. Valley Center, Kansas

WATER WELL OWNER: PORTER, Steve RR#, ST. ADDRESS, BOX #: 601 W. 93rd N. CITY, STATE, ZIP CODE: Valley Center, Kansas	Board of Agriculture, Division of Water Resource Application Number:
--	---

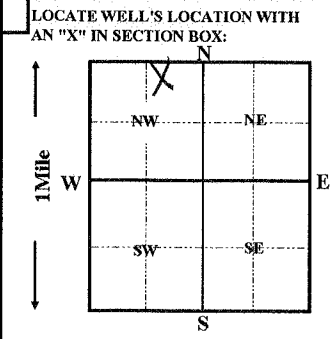

4 DEPTH OF COMPLETED WELL 97 ft.	ELEVATION:	
Depth(s) groundwater Encountered 1 ft.	2 ft.	3 ft.
WELL'S STATIC WATER LEVEL 30 FT. BELOW LAND SURFACE MEASURED ON 10/08/1996	mo/day/yr	
Pump test data: Well water was ft. after hours pumping gpm		
Est. Yield gpm: Well water was ft. after hours pumping gpm		
Bore Hole Diameter 12 in. to 97 ft. and in. to ft.		
WELL WATER TO BE USED AS:		
1 Domestic 3 Feedlot 6 Oil field water supply 9 Dewatering 12 Other (Specify below)	5 Public water supply 8 Air conditioning 11 Injection well	
2 Irrigation 4 Industrial 7 Lawn and garden only 10 Monitoring well		
Was a chemical/bacteriological sample submitted to Department? Yes No X ; If yes, mo/day/yr sample was submitted Water Well Disinfected? Yes X No		

5 TYPE OF CASING USED:		5 Wrought iron	8 Concrete tile	CASING JOINTS:	Glued X Clamped
1 Steel	3 RMP (SR)	6 Asbestos-Cement	9 Other (Specify below)	Welded	
2 PVC	4 ABS	7 Fiberglass	SDR-26	Threaded	
Blank casing Diameter 5 in. to 37 ft., Dia		in. to ft., Dia	in. to ft.	Weight	in. to ft.
Casing height above land surface 12 in., weight 2.35 lbs. / ft.		Wall thickness or gauge No. .214			
TYPE OF SCREEN OR PERFORATION MATERIAL:					
1 Steel	3 Stainless Steel	5 Fiberglass	8 RMP (SR)	10 Asbestos-cement	
2 Brass	4 Galvanized steel	6 Concrete tile	9 ABS	11 other (specify)	
SCREEN OR PERFORATION OPENING ARE:			8 Saw cut	11 None (open hole)	
1 Continous slot	3 Mill slot	5 Gauzed wrapped	9 Drilled holes		
2 Louvered shutter	4 Key punched	6 Wire wrapped	10 Other (specify)		
SCREEN-PERFORATION INTERVALS: from 37 ft. to 97 ft., From ft. to ft.					
GRAVEL PACK INTERVALS: from 24 ft. to 97 ft., From ft. to ft.					

6 GROUT MATERIAL: 1 Neat cement		2 Cement grout	3 Bentonite	4 Other bentonite hole plug
GROUT INTERVALS: From 4 ft. to 24 ft. From ft. From ft. From ft. From ft.				
What is the nearest source of possible contamination:				
1 Septic tank	4 Lateral lines	7 Pit privy	10 Livestock pens	14 Abandon water well
2 Sewer lines	5 Cess pool	8 Sewage lagoon	11 Fuel storage	15 Oil well/Gas well
3 Watertight sewer lines	6 Seepage pit	9 Feedyard	12 Fertilizer storage	16 Other (specify below)
				None Apparent

Direction from well?		How many feet?				
FROM	TO	LITHOLOGIC LOG		FROM	TO	PLUGGING INTERVALS
0	2	topsol				
2	8	sand				
8	15	clay				
15	20	fine sand				
20	34	clay				
34	43	medium sand				
43	97	shale				

7 CONTRACTOR'S OR LANDOWNER'S CERTIFICATION: This water well was (1) constructed, (2) reconstructed, or (3) plugged under my jurisdiction and was completed on (mo/day/year) **10/08/1996** and this record is true to the best of my knowledge and belief. Kansas Water Well Contractor's License No. **236**. This Water Well Record was completed on (mo/day/yr) **10/09/96**. Under the business name of **Harp Well & Pump Service, Inc.** by (signature) *Todd S. Harp*