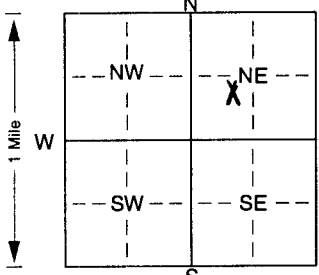


1 LOCATION OF WATER WELL: County: Sedgwick	Fraction N 1/4 Sec 14 E 1/4 R 1	Section Number 31	Township Number T 25 S	Range Number R 1 EAST
--	---	-----------------------------	----------------------------------	--

Distance and direction from nearest town or city street address of well if located within city?
13 2nd St. Cir - Valley Center Ks

2 WATER WELL OWNER: **Mark Quies**
 RR#, St. Address, Box #: **13 2nd St. Cir**
 City, State, ZIP Code: **Valley Center, KS**
 Board of Agriculture, Division of Water Resources
 Application Number:

3 LOCATE WELL'S LOCATION WITH AN "X" IN SECTION BOX:

 4 DEPTH OF COMPLETED WELL: **32** ft. ELEVATION:
 Depth(s) Groundwater Encountered 1. **12** ft. 2. _____ ft. 3. _____ ft.
 WELL'S STATIC WATER LEVEL **12** ft. below land surface measured on mo/day/yr **3:5:01**
 Pump test data: Well water was _____ ft. after _____ hours pumping _____ gpm
 Est. Yield _____ gpm: Well water was _____ ft. after _____ hours pumping _____ gpm
 Bore Hole Diameter: **10** in. to **32** ft., and _____ in. to _____ ft.
 WELL WATER TO BE USED AS:
 5 Public water supply 8 Air conditioning 11 Injection well
 1 Domestic 3 Feedlot 6 Oil field water supply 9 Dewatering 12 Other (Specify below)
 2 Irrigation 4 Industrial 7 **Domestic (lawn & garden)** 10 Monitoring well
 Was a chemical/bacteriological sample submitted to Department? Yes. _____ No. ; If yes, mo/day/yr sample was submitted Water Well Disinfected? Yes No _____

5 TYPE OF BLANK CASING USED:
 1 Steel 3 RMP (SR) 5 Wrought iron 8 Concrete tile CASING JOINTS: Glued. Clamped. _____
 2 **PVC** 4 ABS 6 Asbestos-Cement 9 Other (specify below) Welded _____
 7 Fiberglass Threaded _____
 Blank casing diameter **5** in. to **32** ft., Dia _____ in. to _____ ft., Dia _____ in. to _____ ft.
 Casing height above land surface: **14** in., weight **160** lbs./ft. Wall thickness or gauge No. _____
 TYPE OF SCREEN OR PERFORATION MATERIAL:
 1 Steel 3 Stainless steel 5 Fiberglass **PVC** 10 Asbestos-cement
 2 Brass 4 Galvanized steel 6 Concrete tile 8 RMP (SR) 11 Other (specify) _____
 9 ABS 12 None used (open hole)
 SCREEN OR PERFORATION OPENINGS ARE:
 1 **Continuous slot** 3 Mill slot 5 Gauzed wrapped 8 Saw cut 11 None (open hole)
 2 Louvered shutter 4 Key punched 7 Wire wrapped 9 Drilled holes
 7 Torch cut 10 Other (specify) _____ ft.
 SCREEN-PERFORATED INTERVALS: From **25** ft. to **32** ft., From _____ ft. to _____ ft.
 From _____ ft. to _____ ft., From _____ ft. to _____ ft.
 GRAVEL PACK INTERVALS: From **22** ft. to **32** ft., From _____ ft. to _____ ft.
 From _____ ft. to _____ ft., From _____ ft. to _____ ft.

6 GROUT MATERIAL: 1 Neat cement 2 Cement grout 3 **Bentonite** 4 Other _____
 Grout Intervals: From **3** ft. to **22** ft., From _____ ft. to _____ ft., From _____ ft. to _____ ft.
 What is the nearest source of possible contamination:
 1 Septic tank 4 Lateral lines 7 Pit privy 10 Livestock pens 14 Abandoned water well
 2 Sewer lines 5 Cess pool 8 Sewage lagoon 11 Fuel storage 15 Oil well/Gas well
 3 **Watertight sewer lines** 6 Seepage pit 9 Feedyard 12 Fertilizer storage 16 Other (specify below) _____
 13 Insecticide storage _____
 Direction from well? **N 1/4** How many feet? **20'**

FROM	TO	LITHOLOGIC LOG	FROM	TO	PLUGGING INTERVALS
0	2	Topsoil			
2	11	Clay			
11	14	fine sand			
14	31	Med Gravel			
31	32	Clay			

7 CONTRACTOR'S OR LANDOWNER'S CERTIFICATION: This water well was (1) constructed, (2) reconstructed, or (3) plugged under my jurisdiction and was completed on (mo/day/year) **3:5:01** and this record is true to the best of my knowledge and belief. Kansas Water Well Contractor's Licence No. **6011** This Water Well Record was completed on (mo/day/yr) **3:5:01** under the business name of **Chase Drilling** by (signature) **D. Chase**