


1 LOCATION OF WATER WELL: County: <b>Sedgwick</b>	Fraction <b>NW ¼ NW ¼ SW ¼</b>	Section Number <b>31</b>	Township Number <b>T 25 S</b>	Range Number <b>R 01</b>	<b>E</b>
--	-----------------------------------	-----------------------------	----------------------------------	-----------------------------	----------

Distance and direction from nearest town or city street address of well if located within city?  
**100 S. Meridian, Valley Center**

2 WATER WELL OWNER: **M&M Convenience Stores, Inc.**  
 RR#, St. Address, Box # : **2849 W. 4<sup>th</sup> Avenue**  
 City, State, ZIP Code : **El Dorado, KS 67042**  
 Board of Agriculture, Division of Water Resources  
 Application Number:

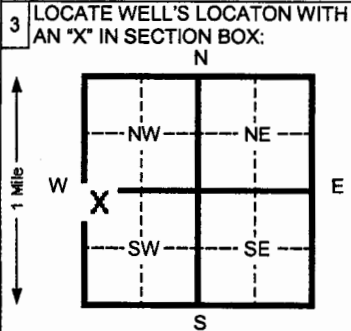

4 DEPTH OF COMPLETED WELL **24.5** ft. ELEVATION: **1344.54 (TOC)**  
 Depth(s) Groundwater Encountered 1 **16** ft. 2 \_\_\_\_\_ ft. 3 \_\_\_\_\_ ft.  
 WELL'S STATIC WATER LEVEL **13.27** ft. below land surface measured on mo/day/yr **1-25-05**  
 Pump test data: Well water was \_\_\_\_\_ ft. after \_\_\_\_\_ hours pumping \_\_\_\_\_ gpm  
 Est. Yield \_\_\_\_\_ gpm: Well water was \_\_\_\_\_ ft. after \_\_\_\_\_ hours pumping \_\_\_\_\_ gpm  
 Bore Hole Diameter **8.5** in. to **24.5** ft. and \_\_\_\_\_ in. to \_\_\_\_\_ ft.  
 WELL WATER TO BE USED AS: 5 Public water supply 8 Air conditioning 11 Injection well  
 1 Domestic 3 Feed lot 6 Oil field water supply 9 Dewatering 12 Other (Specify below)  
 2 Irrigation 4 Industrial 7 Lawn and garden (domestic) **10 Monitoring well**  
 Was a chemical/bacteriological sample submitted to Department? Yes \_\_\_\_\_ No **X** If yes, mo/day/yr sample was submitted \_\_\_\_\_  
 Water Well Disinfected? Yes \_\_\_\_\_ No **X**

5 TYPE OF BLANK CASING USED:  
 1 Steel 3 RMP (SR) 5 Wrought Iron 8 Concrete tile CASING JOINTS: Glued \_\_\_\_\_ Clamped \_\_\_\_\_  
**2 PVC** 4 ABS 6 Asbestos-Cement 9 Other (specify below) Welded \_\_\_\_\_  
 7 Fiberglass \_\_\_\_\_ Threaded \_\_\_\_\_ **Flush**  
 Blank casing diameter **4** in. to **9.5** ft., Dia \_\_\_\_\_ in. to \_\_\_\_\_ ft., Dia \_\_\_\_\_ in. to \_\_\_\_\_ ft.  
 Casing height above land surface **Flush** in., weight **2.0** lbs./ft. Wall thickness or gauge No. **Sch. 40**

TYPE OF SCREEN OR PERFORATION MATERIAL:  
 1 Steel 3 Stainless steel 5 Fiberglass 8 RMP (SR) 11 Other (specify) \_\_\_\_\_  
 2 Brass 4 Galvanized steel 6 Concrete tile 9 ABS 12 None used (open hole)  
 SCREEN OR PERFORATION OPENINGS ARE:  
 1 Continuous slot **3 Mill slot** 5 Gauzed wrapped 8 Saw cut 11 None (open hole)  
 2 Louvered shutter 4 Key punched 7 Torch cut 10 Other (specify) \_\_\_\_\_  
 SCREEN-PERFORATED INTERVALS: From **9.5** ft. to **24.5** ft. From \_\_\_\_\_ ft. to \_\_\_\_\_ ft.  
 From \_\_\_\_\_ ft. to \_\_\_\_\_ ft. From \_\_\_\_\_ ft. to \_\_\_\_\_ ft.  
 GRAVEL PACK INTERVALS: From **7.5** ft. to **24.5** ft. From \_\_\_\_\_ ft. to \_\_\_\_\_ ft.  
 From \_\_\_\_\_ ft. to \_\_\_\_\_ ft. From \_\_\_\_\_ ft. to \_\_\_\_\_ ft.

6 GROUT MATERIAL: 1 Neat cement 2 Cement grout **3 Bentonite** 4 Other \_\_\_\_\_  
 Grout Intervals From **0.5** ft. to **7.5** ft. From \_\_\_\_\_ ft. to \_\_\_\_\_ ft. From \_\_\_\_\_ ft. to \_\_\_\_\_ ft.  
 What is the nearest source of possible contamination:  
 1 Septic tank 4 Lateral lines 7 Pit privy 10 Livestock pens 14 Abandoned water well  
 2 Sewer lines 5 Cess pool 8 Sewage lagoon 11 Fuel storage 15 Oil well/ Gas well  
 3 Watertight sewer lines 6 Seepage pit 9 Feedyard 12 Fertilizer storage 16 Other (specify below)  
 13 Insecticide storage \_\_\_\_\_  
 Direction from well? \_\_\_\_\_ How many feet? \_\_\_\_\_

FROM	TO	CODE	LITHOLOGIC LOG	FROM	TO	PLUGGING INTERVALS
0	0.5		Concrete			
0.5	9		Silty sand, with sand, low to mod plasticity, fine sand to pebbles			
9	24.5		Sand, with silt, mod. plasticity, fine grained, blocky, soft			

7 CONTRACTOR'S OR LANDOWNER'S CERTIFICATION: This water well was **(1) constructed**, (2) reconstructed, or (3) plugged under my jurisdiction and was completed on (mo/day/yr) **2-17-05** and this record is true to the best of my knowledge and belief. Kansas Water Well Contractor's License No. **531** This Water Well Record was completed on (mo/day/yr) **3-9-05** under the business name of **Geotechnical Services, Inc.** by (signature) \_\_\_\_\_

INSTRUCTIONS: Please fill in blanks and circle the correct answers. Send three copies to Kansas Department of Health and Environment, Bureau of Water, 1000 S W Jackson St., Ste. 420, Topeka, Kansas 66612-1367. Telephone: 913-296-5545. Send one to WATER WELL OWNER and retain one for your records.