


1 LOCATION OF WATER WELL: County: Sedgwick	Fraction NW ¼ NW ¼ SW ¼	Section Number 31	Township Number T 25 S	Range Number R 01 E
--	-----------------------------------	-----------------------------	----------------------------------	-------------------------------

Distance and direction from nearest town or city street address of well if located within city?
100 S. Meridian, Valley Center

2 WATER WELL OWNER: RR#, St. Address, Box # City, State, ZIP Code	M&M Convenience Stores, Inc. 2849 W. 4th Avenue El Dorado, KS 67042	Board of Agriculture, Division of Water Resources Application Number:
---	---	--

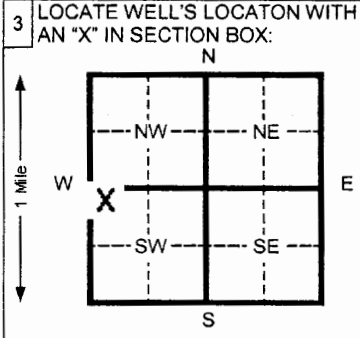

4 DEPTH OF COMPLETED WELL	25 ft. ELEVATION:
Depth(s) Groundwater Encountered 1 15 ft. 2 _____ ft. 3 _____ ft.	
WELL'S STATIC WATER LEVEL _____ ft. below land surface measured on mo/day/yr	
Pump test data: Well water was _____ ft. after _____ hours pumping _____ gpm	
Est. Yield _____ gpm: Well water was _____ ft. after _____ hours pumping _____ gpm	
Bore Hole Diameter 8.5 in. to 25 ft. and _____ in. to _____ ft.	
WELL WATER TO BE USED AS:	
1 Domestic 3 Feed lot 6 Oil field water supply	8 Air conditioning 11 Injection well
2 Irrigation 4 Industrial 7 Lawn and garden (domestic)	9 Dewatering 12 Other (Specify below)
	10 Monitoring well
Was a chemical/bacteriological sample submitted to Department? Yes _____ No X If yes, mo/day/yr sample was submitted _____	Water Well Disinfected? Yes _____ No X

5 TYPE OF BLANK CASING USED:	5 Wrought Iron 8 Concrete tile	CASING JOINTS: Glued _____ Clamped _____
1 Steel 3 RMP (SR)	6 Asbestos-Cement 9 Other (specify below)	Welded _____
2 PVC 4 ABS	7 Fiberglass	Threaded _____ Flush
Blank casing diameter 2 in. to 23 ft., Dia _____ in. to _____ ft., Dia _____ in. to _____ ft.		
Casing height above land surface Flush in., weight 0.703 lbs./ft. Wall thickness or gauge No. Sch. 40		
TYPE OF SCREEN OR PERFORATION MATERIAL:	7 PVC 10 Asbestos-cement	
1 Steel 3 Stainless steel 5 Fiberglass 8 RMP (SR) 11 Other (specify) _____		
2 Brass 4 Galvanized steel 6 Concrete tile 9 ABS 12 None used (open hole)		
SCREEN OR PERFORATION OPENINGS ARE:	5 Gauzed wrapped 8 Saw cut 11 None (open hole)	
1 Continuous slot 3 Mill slot 6 Wire wrapped 9 Drilled holes		
2 Louvered shutter 4 Key punched 7 Torch cut 10 Other (specify) _____		
SCREEN-PERFORATED INTERVALS: From 23 ft. to 25 ft. From _____ ft. to _____ ft.		
GRAVEL PACK INTERVALS: From 21 ft. to 25 ft. From _____ ft. to _____ ft.		

6 GROUT MATERIAL:	1 Neat cement 2 Cement grout 3 Bentonite 4 Other _____
Grout Intervals From 1 ft. to 21 ft. From _____ ft. to _____ ft. From _____ ft. to _____ ft.	
What is the nearest source of possible contamination:	
1 Septic tank 4 Lateral lines 7 Pit privy 10 Livestock pens 14 Abandoned water well	
2 Sewer lines 5 Cess pool 8 Sewage lagoon 11 Fuel storage 15 Oil well/ Gas well	
3 Watertight sewer lines 6 Seepage pit 9 Feedyard 12 Fertilizer storage 16 Other (specify below)	
13 Insecticide storage	
Direction from well? _____ How many feet? _____	

FROM	TO	CODE	LITHOLOGIC LOG	FROM	TO	PLUGGING INTERVALS
0	0.5		Concrete			
0.5	5		Sandy Silt with Clay			
5	7		Clayey Silt			
7	11		Silty Clay			
11	14		Clayey Silt			
14	15		Clayey Silt			
15	20		Sand, medium grain			
20	25		Clay with fine grain sand			

7 CONTRACTOR'S OR LANDOWNER'S CERTIFICATION: This water well was (1) constructed , (2) reconstructed, or (3) plugged under my jurisdiction and was completed on (mo/day/yr) 7-19-05 and this record is true to the best of my knowledge and belief. Kansas Water Well Contractor's License No. 531 This Water Well Record was completed on (mo/day/yr) 8-11-05 under the business name of Geotechnical Services, Inc. by (signature) <i>William G. [Signature]</i>

INSTRUCTIONS: Please fill in blanks and circle the correct answers. Send three copies to Kansas Department of Health and Environment, Bureau of Water, 1000 S W Jackson St., Ste. 420, Topeka, Kansas 66612-1367. Telephone: 913-296-5545. Send one to WATER WELL OWNER and retain one for your records.

OFFICE USE ONLY

SEC