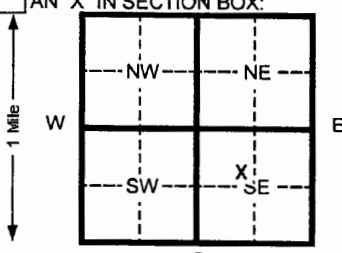
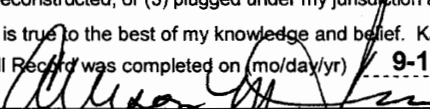


WATER WELL RECORD Form WWC-5 KSA 82a-1212 ID No.

1 LOCATION OF WATER WELL:		Fraction	Section Number	Township Number	Range Number	
County: Sedgwick		SE 1/4 NW 1/4 SE 1/4	17	T 26 S	R 01 E	
Distance and direction from nearest town or city street address of well if located within city? 1/2 mile north, 1/8 mile west of 53rd St. and Broadway Ave. intersection, located in an open field.						
2 WATER WELL OWNER:		US EPA				
RR#, St. Address, Box # :		726 Minnesota		Board of Agriculture, Division of Water Resources		
City, State, ZIP Code :		Kansas City, KS 66101		Application Number:		
3 LOCATE WELL'S LOCATION WITH AN "X" IN SECTION BOX:		4 DEPTH OF COMPLETED WELL 44.5 ft. ELEVATION:				
		Depth(s) Groundwater Encountered 1 15 ft. 2 _____ ft. 3 _____ ft. WELL'S STATIC WATER LEVEL _____ ft. below land surface measured on mo/day/yr _____ Pump test data: Well water was _____ ft. after _____ hours pumping _____ gpm Est. Yield _____ gpm: Well water was _____ ft. after _____ hours pumping _____ gpm Bore Hole Diameter 8.5 in. to 44.5 ft. and _____ in. to _____ ft. WELL WATER TO BE USED AS: 5 Public water supply 8 Air conditioning 11 Injection well 1 Domestic 3 Feed lot 6 Oil field water supply 9 Dewatering 12 Other (Specify below) 2 Irrigation 4 Industrial 7 Lawn and garden (domestic) 10 Monitoring well Was a chemical/bacteriological sample submitted to Department? Yes _____ No X If yes, mo/day/yr sample was submitted _____ Water Well Disinfected? Yes _____ No X				
5 TYPE OF BLANK CASING USED:		5 Wrought Iron 8 Concrete tile CASING JOINTS: Glued _____ Clamped _____				
1 Steel 3 RMP (SR)		6 Asbestos-Cement 9 Other (specify below) Welded _____				
2 PVC 4 ABS		7 Fiberglass _____ Threaded _____				
Blank casing diameter 2 in. to 34.5 ft. Dia _____ in. to _____ ft. Dia _____ in. to _____ ft.		Casing height above land surface 30 in., weight 0.703 lbs./ft. Wall thickness or gauge No. Sch. 40				
TYPE OF SCREEN OR PERFORATION MATERIAL:		7 PVC 10 Asbestos-cement				
1 Steel 3 Stainless steel 5 Fiberglass 8 RMP (SR) 11 Other (specify) _____		2 Brass 4 Galvanized steel 6 Concrete tile 9 ABS 12 None used (open hole)				
SCREEN OR PERFORATION OPENINGS ARE:		5 Gauzed wrapped 8 Saw cut 11 None (open hole)				
1 Continuous slot 3 Mill slot 6 Wire wrapped 9 Drilled holes		2 Louvered shutter 4 Key punched 7 Torch cut 10 Other (specify) _____				
SCREEN-PERFORATED INTERVALS: From 34.5 ft. to 44.5 ft. From _____ ft. to _____ ft.		From _____ ft. to _____ ft. From _____ ft. to _____ ft.				
GRAVEL PACK INTERVALS: From 30.5 ft. to 44.5 ft. From _____ ft. to _____ ft.		From _____ ft. to _____ ft. From _____ ft. to _____ ft.				
6 GROUT MATERIAL:		1 Neat cement 2 Cement grout 3 Bentonite 4 Other _____				
Grout Intervals From _____ ft. to _____ ft. From _____ ft. to _____ ft.		From _____ ft. to _____ ft. From _____ ft. to _____ ft.				
What is the nearest source of possible contamination:		10 Livestock pens 14 Abandoned water well				
1 Septic tank 4 Lateral lines 7 Pit privy 11 Fuel storage 15 Oil well/ Gas well		2 Sewer lines 5 Cess pool 8 Sewage lagoon 12 Fertilizer storage 16 Other (specify below)				
3 Watertight sewer lines 6 Seepage pit 9 Feedyard 13 Insecticide storage		Direction from well? _____ How many feet? _____				
FROM	TO	CODE	LITHOLOGIC LOG	FROM	TO	PLUGGING INTERVALS
0	4	CL	Clay, trace silt			
4	8.5	SC	Clay, very sandy			
8.5	11		Clay, sandy			
11	25	SW	Sand, 1-2" clay lenses throughout			
25	44.5	SP	Sand, fine to coarse grain, poorly sorted			
7 CONTRACTOR'S OR LANDOWNER'S CERTIFICATION: This water well was (1) constructed , (2) reconstructed, or (3) plugged under my jurisdiction and was completed on (mo/day/yr) 9-2-05 and this record is true to the best of my knowledge and belief. Kansas						
Water Well Contractor's License No. 531			This Water Well Record was completed on (mo/day/yr) 9-13-05			
under the business name of Geotechnical Services, Inc.			by (signature) 			
INSTRUCTIONS: Please fill in blanks and circle the correct answers. Send three copies to Kansas Department of Health and Environment, Bureau of Water, 1000 S W Jackson St., Ste. 420, Topeka, Kansas 66612-1367. Telephone: 913-296-5545. Send one to WATER WELL OWNER and retain one for your records.						

OFFICE USE ONLY

—

2

350