


WATER WELL RECORD Form WWC-5 KSA 82a-1212

1 LOCATION OF WATER WELL: Sedgwick	FRACTION NE 1/4 SW 1/4 NE 1/4	SECTION NUMBER 33	TOWNSHIP NUMBER T 25 S	RANGE NUMBER R 1E E/W
---	---	-----------------------------	----------------------------------	---------------------------------

Distance and direction from nearest town or city street address of well if located within city?
77th St. and Broadway Park City, Kansas

2 WATER WELL OWNER: HARTMAN ARENA	Board of Agriculture, Division of Water Resource
RR#, ST. ADDRESS, BOX #: 8151 N. I-35	Application Number:
CITY, STATE: Park City, Kansas	ZIP CODE:

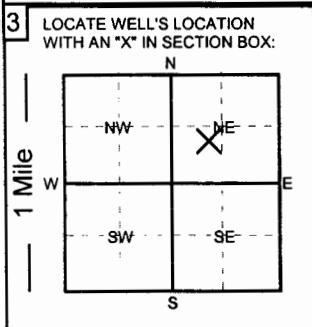

4 DEPTH OF COMPLETED WELL: 125 ft.	ELEVATION:
Depth of groundwater Encountered: _____ ft.	_____ ft.
WELL'S STATIC WATER LEVEL 20 FT. BELOW LAND SURFACE MEASURED ON 10/9/08	
Pump test data: Well water was _____ ft. after _____ hours of pumping @ _____ gpm	
Est. Yield: _____ gpm	Well water was _____ ft. after _____ hours of pumping @ _____ gpm
Bore Hole Diameter 12 in. to 125 ft. and _____ in. to _____ ft.	
WELL WATER TO BE USED AS:	
1. Domestic 3. Feedlot 5. Public water supply 7. Lawn and garden only 9. Dewatering 11. Injection well	12. Other (Specify below)
2. Irrigation 4. Industrial 6. Oil field water supply 8. Air conditioning 10. Monitoring well	
Was a chemical/bacteriological sample submitted to Department? YES NO ; if yes, what mo/day/yr was sample submitted	
Was Water Well Disinfected? YES NO	

5 TYPE OF CASING USED:	5. Wrought Iron 7. Fiberglass 9. Other (Specify below)	CASING JOINTS: Glued Threaded	Welded Clamped
1. Steel 3. RPM (SR)	6. Asbestos-Cement 8. Concrete tile	SDR-26	
2. PVC 4. ABS			
Blank casing diameter 5 in. to 25 ft., Dia. _____ in. to _____ ft.			
Casing height above land surface: 12 in., Weight: 2.35 lbs. / ft.		Wall thickness or gauge No. .214	
TYPE OF SCREEN OR PERFORATION MATERIAL:			
1. Steel 3. Stainless Steel 5. Fiberglass 7. PVC 9. ABS 11. Other (specify)	2. Brass 4. Galvanized 6. Concrete Tile 8. RMP (SR) 10. Asbestos-Cement 12. None used (open hole)		
SCREEN OR PERFORATION OPENINGS ARE:			
1. Continuous slot 3. Mill slot 5. Gauzed wrapped 7. Torch cut 9. Drilled holes 11. None (open hole)	2. Louvered shutter 4. Key punched 6. Wire wrapped 8. Saw cut 10. Other (specify)		
SCREEN - PERFORATION INTERVAL	From 25 ft. to 125 ft.,	From _____ ft. to _____ ft.	From _____ ft. to _____ ft.
	From _____ ft. to _____ ft.,	From _____ ft. to _____ ft.	From _____ ft. to _____ ft.
GRAVEL PACK INTERVALS:	From 24 ft. to 125 ft.,	From _____ ft. to _____ ft.	From _____ ft. to _____ ft.
	From _____ ft. to _____ ft.,	From _____ ft. to _____ ft.	From _____ ft. to _____ ft.

6 GROUT MATERIALS:	1. Neat cement 2. Cement Grout 3. Bentonite	Other bentonite hole plug	From _____ ft. to _____ ft.
Grout Intervals: From 4 ft. to 24 ft.,	From _____ ft. to _____ ft.	From _____ ft. to _____ ft.	From _____ ft. to _____ ft.
What is the nearest source of possible contamination:			
1. Septic tank 4. Lateral lines 7. Pit privy 10. Livestock pens 13. Insecticide storage 15. Oil well/Gas well	2. Sewer lines 5. Cess Pool 8. Sewage lagoon 11. Fuel storage 14. Abandon water well 16. Other (specify below)		
3. Watertight sewer line 6. Seepage pit 9. Feed yard 12. Fertilizer storage			
Direction from well? East	How many feet? 50 ft. plus		

From	To	LITHOLOGIC LOG	From	To	LITHOLOGIC LOG
0	4	topsoil			
4	25	clay			
25	32	fine sand			
32	125	shale and limestone			

7 Contractor's or Landowner's Certification: This water well was 1. constructed 2. reconstructed or 3. plugged under my jurisdiction and was completed on (mo/day/year) 10-09-2008 and this record is true to the best of my knowledge and belief.	
Kansas Water Well Contractor's License No. 236	This water well record was completed on (mo/day/year) 10/10/2008
under the business name of Harp Well and Pump Service	by (signature) Todd S. Harp