


<b>1 LOCATION OF WATER WELL:</b> County: <b>Sedgwick</b>	Fraction <b>SE ¼ SE ¼ SW ¼</b>	Section Number <b>24</b>	Township Number <b>25S</b>	Range Number <b>1</b>
---	-----------------------------------	-----------------------------	-------------------------------	--------------------------

Distance and direction from nearest town or city street address of well if located within city?  
**5360 E. 93<sup>rd</sup> St. - Wichita**

<b>2 WATER WELL OWNER: Paul D. Weishaar</b>  RR#, St. Address, Box #: <b>5360 W. Harborlight St.</b>  City, State, ZIP Code: <b>Valley Center, KS 67147</b>	<b>Global Positioning System</b> (decimal degrees, min. of 4 digits) Latitude: <b>N 37.85433</b> Longitude: <b>W 97.27375</b> Elevation: _____ Datum: <b>NAD83</b> Data Collection Method: <b>Digital Map/Photo</b>
---	--

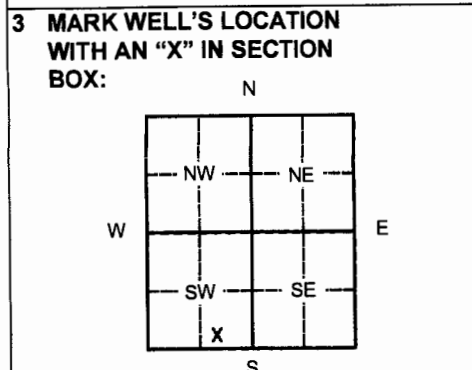

**4 DEPTH OF WELL** 13.2 ft.

WELL'S STATIC WATER LEVEL 10.2 ft

WELL WAS USED AS:

1 Domestic	5 Public Water Supply	9 Dewatering
2 Irrigation	6 Oil Field Water Supply	10 Monitoring
3 Feedlot	7 Domestic (Lawn & Garden)	11 Injection Well
4 Industrial	8 Air Conditioning	12 Other _____

Was a chemical/bacteriological sample submitted to Department? Yes \_\_\_ No **X**

**5 TYPE OF BLANK CASING USED:**

1 Steel	3 RMP (SR)	5 Wrought	7 Fiberglass	9 <b>Other (Specify below)</b>
2 PVC	4 ABS	6 Asbestos-Cement	8 Concrete Tile	<b>Rock with mortar</b>

Blank casing diameter 24 in. Was casing pulled? Yes \_\_\_ No **X** If yes, how much **Note: Pulled 12 ft. of 1-in. poly pipe connected to pump.**  
 Casing height above or below land surface NA in.

**6 GROUT PLUG MATERIAL:** 1 **Neat cement** 2 Cement grout 3 **Bentonite** 4 Other \_\_\_\_\_

Grout Plug Intervals: From 13.2 ft. to 4 ft., From 4 ft. to 3 ft., From \_\_\_\_\_ to \_\_\_\_\_ ft.

What is the nearest source of possible contamination:

1 <b>Septic tank</b>	6 Seepage pit	11 Fuel Storage	16 Other (specify below)
2 Sewer lines	7 Pit privy	12 Fertilizer storage	
3 Watertight sewer lines	8 Sewage lagoon	13 Insecticide storage	
4 Lateral lines	9 Feedyard	14 Abandoned water well	Direction from well?
5 Cess pool	10 Livestock pens	15 Oil well/Gas well	How many feet?

FROM	TO	PLUGGING MATERIALS	FROM	TO	PLUGGING MATERIALS
0	3.0	Compacted native clay soil			
3.0	4.0	Bentonite chips			
4.0	13.2	Neat cement			

**7 CONTRACTOR'S OR LANDOWNER'S CERTIFICATION:** This water well was plugged under my jurisdiction and was completed on (mo/day/year) 01/08/13 and this record is true to the best of my knowledge and belief. Kansas Water Well Contractor's License No. 531. This Water Well Record was completed on (mo/day/year) 01/09/13 under the business name of GSI Engineering, LLC by (signature) *[Signature]*

**INSTRUCTIONS:** Please fill in blanks or circle the correct answers. Send top three copies to Kansas Department of Health and Environment, Bureau of Water, Geology Section, 1000 SW Jackson St., Ste. 420, Topeka, Kansas 66612-1367. Telephone: 785/296-5522. Send one to Water Well Owner and retain one for your records. Visit us at <http://www.kdheks.gov/waterwell>.