

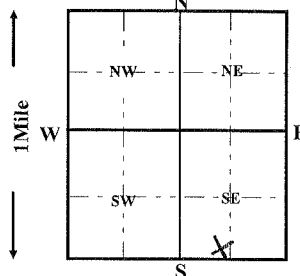
1 LOCATION OF WATER WELL: Sedgwick	FRACTION SE 1/4 SW 1/4 SE 1/4	Section Number 15	Township Number T 25 S	Range Number R 1E E/W
---	---	-----------------------------	----------------------------------	---------------------------------

Distance and direction from nearest town or city street address of well if located within city?
2800 E. 101st N. Valley Center, Kansas

WATER WELL OWNER: **HESS, Bart**
 RR#, ST. ADDRESS, BOX #: **2800 E. 101st N.**
 CITY, STATE, ZIP CODE: **Valley Center, Kansas**

Board of Agriculture, Division of Water Resource

Application Number:

LOCATE WELL'S LOCATION WITH AN "X" IN SECTION BOX: 	4 DEPTH OF COMPLETED WELL 25 ft.	ELEVATION: well pit
	Depth(s) groundwater Encountered 1 ft. 2 ft. 3 ft.	WELL'S STATIC WATER LEVEL 10 FT. BELOW LAND SURFACE MEASURED ON 06/18/1998
	Pump test data: Well water was ft. after hours pumping gpm	
	Est. Yield gpm: Well water was ft. after hours pumping gpm	
Bore Hole Diameter UNKNOWN in. to ft. and in. to ft.		
WELL WATER TO BE USED AS: 5 Public water supply 8 Air conditioning 11 Injection well		
1 Domestic 3 Feedlot 6 Oil field water supply 9 Dewatering 12 Other (Specify below)		
2 Irrigation 4 Industrial 7 Lawn and garden only 10 Monitoring well		
Was a chemical/bacteriological sample submitted to Department? Yes No ; If yes, mo/day/yr sample was submitted		
Water Well Disinfected? Yes <input checked="" type="checkbox"/> No		

5 TYPE OF CASING USED:	5 Wrought iron	8 Concrete tile	CASING JOINTS: Glued Clamped
1 Steel	3 RMP (SR)	6 Asbestos-Cement	Welded
2 PVC	4 ABS	7 Fiberglass	Threaded
9 Other (Specify below)			
Blank casing Diameter 1 1/4 in. to 25 ft., Dia in. to ft., Dia in. to ft.			
Casing height ^{below} above land surface 60 in., weight lbs./ ft. Wall thickness or gauge No.			
TYPE OF SCREEN OR PERFORATION MATERIAL:	7 PVC	10 Asbestos-cement	
1 Steel	3 Stainless Steel	5 Fiberglass	8 RMP (SR) 11 other (specify) N/A
2 Brass	4 Galvanized steel	6 Concrete tile	9 ABS 12 None used (open hole)
SCREEN OR PERFORATION OPENING ARE:	5 Gauzed wrapped	8 Saw cut	11 None (open hole)
1 Continuous slot	3 Mill slot	6 Wire wrapped	9 Drilled holes
2 Louvered shutter	4 Key punched	7 Torch cut	10 Other (specify) N/A
SCREEN-PERFORATION INTERVALS: from ft. to ft., From ft. to ft.			
GRAVEL PACK INTERVALS: from ft. to ft., From ft. to ft.			

6 GROUT MATERIAL: 1 Neat cement	2 Cement grout	3 Bentonite	4 Other bentonite hole plug
Grout Intervals: From ft. to ft. From ft. to ft.			
What is the nearest source of possible contamination:	10 Livestock pens	14 Abandon water well	
1 Septic tank	4 Lateral lines	7 Pit privy	11 Fuel storage
2 Sewer lines	5 Cess pool	8 Sewage lagoon	12 Fertilizer storage
3 Watertight sewer lines	6 Seepage pit	9 Feedyard	13 Insecticide storage
15 Oil well/Gas well			16 Other (specify below)

Direction from well? **North** How many feet? **60**

FROM	TO	LITHOLOGIC LOG	FROM	TO	PLUGGING INTERVALS
			0	25	bentonite hole plug

7 CONTRACTOR'S OR LANDOWNER'S CERTIFICATION: This water well was (1) constructed, (2) reconstructed, or (3) plugged under my jurisdiction and was completed on (mo/day/year) **06/18/1998** and this record is true to the best of my knowledge and belief. Kansas Water Well Contractor's License No. **236** This Water Well Record was completed on **06/19/98** (mo/day/yr) **Harp Well & Pump Service, Inc** Under the business name of..... by (signature) **Todd S. Harp**