


1 LOCATION OF WATER WELL: Sedgwick	FRACTION SE 1/4 SW 1/4 SE 1/4	Section Number 15	Township Number T 25 S	Range Number R 1E E/W
--	---	-----------------------------	----------------------------------	---------------------------------

Distance and direction from nearest town or city street address of well if located within city?
2800 E. 101st N. Valley Center, Kansas

WATER WELL OWNER: HESS, Bart RR#, ST. ADDRESS, BOX #: 2800 E. 101st N. CITY, STATE, ZIP CODE: Valley Center, Kansas	Board of Agriculture, Division of Water Resource Application Number:
--	---

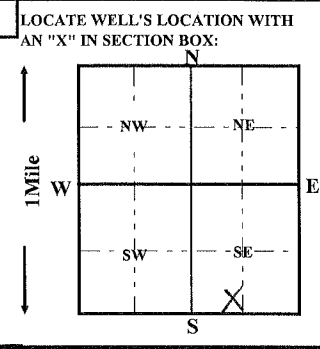

4 DEPTH OF COMPLETED WELL 40 ft.	ELEVATION:	WELL'S STATIC WATER LEVEL 15 FT. BELOW LAND SURFACE MEASURED ON 06/16/1998	mo/day/yr
Depth(s) groundwater Encountered 1 ft.	2 ft.	3 ft.	ft.
Pump test data: Well water was _____ ft. after _____ hours pumping _____ gpm			
Est. Yield gpm: Well water was _____ ft. after _____ hours pumping _____ gpm			
Bore Hole Diameter 12 in. to 40 ft. and _____ in. to _____ ft.			
WELL WATER TO BE USED AS: 5 Public water supply 8 Air conditioning 11 Injection well			
1 Domestic 3 Feedlot 6 Oil field water supply 9 Dewatering 12 Other (Specify below)			
2 Irrigation 4 Industrial 7 Lawn and garden only 10 Monitoring well			
Was a chemical/bacteriological sample submitted to Department? Yes _____ No X ; If yes, mo/day/yr sample was submitted _____			
Water Well Disinfected? Yes X No _____			

5 TYPE OF CASING USED:	5 Wrought iron	8 Concrete tile	CASING JOINTS: X Glued X Clamped
1 Steel 3 RMP (SR)	6 Asbestos-Cement	9 Other (Specify below)	Welded
2 PVC 4 ABS	7 Fiberglass	SDR - 26	Threaded
Blank casing Diameter 5 in. to 25 ft., Dia _____ in. to _____ ft.			
Casing height above land surface 12 in., weight 2.35 lbs. / ft. Wall thickness or gauge No. .214			
TYPE OF SCREEN OR PERFORATION MATERIAL:			
1 Steel 3 Stainless Steel	5 Fiberglass	8 RMP (SR)	11 other (specify)
2 Brass 4 Galvanized steel	6 Concrete tile	9 ABS	12 None used (open hole)
SCREEN OR PERFORATION OPENING ARE:			
1 Continuous slot 3 Mill slot	5 Gauzed wrapped	8 Saw cut	11 None (open hole)
2 Louvered shutter 4 Key punched	6 Wire wrapped	9 Drilled holes	
	7 Torch cut	10 Other (specify)	
SCREEN-PERFORATION INTERVALS: from 25 ft. to 40 ft., From _____ ft. to _____ ft.			
GRAVEL PACK INTERVALS: from 24 ft. to 40 ft., From _____ ft. to _____ ft.			

6 GROUT MATERIAL: 1 Neat cement	2 Cement grout	3 Bentonite	4 Other bentonite hole plug
Grout Intervals: From 4 ft. to 24 ft. From _____ ft. to _____ ft.			
What is the nearest source of possible contamination:			
1 Septic tank 4 Lateral lines	7 Pit privy	10 Livestock pens	14 Abandon water well
2 Sewer lines 5 Cess pool	8 Sewage lagoon	11 Fuel storage	15 Oil well/Gas well
3 Watertight sewer lines 6 Seepage pit	9 Feedyard	12 Fertilizer storage	16 Other (specify below)
		13 Insecticide storage	
Direction from well? North		How many feet? 150	

FROM	TO	LITHOLOGIC LOG	FROM	TO	PLUGGING INTERVALS
0	4	topsoil			
4	15	clay			
15	32	medium fine sand			
32	40	shale			

7 CONTRACTOR'S OR LANDOWNER'S CERTIFICATION: This water well was (1) constructed, (2) reconstructed, or (3) plugged under my jurisdiction and was completed on (mo/day/year) 06/16/1998 and this record is true to the best of my knowledge and belief. Kansas Water Well Contractor's License No. 236 This Water Well Record was completed on 06/17/98 (mo/day/yr) Harp Well & Pump Service, Inc Under the business name of _____ by (signature) <i>Todd S. Harp</i>
